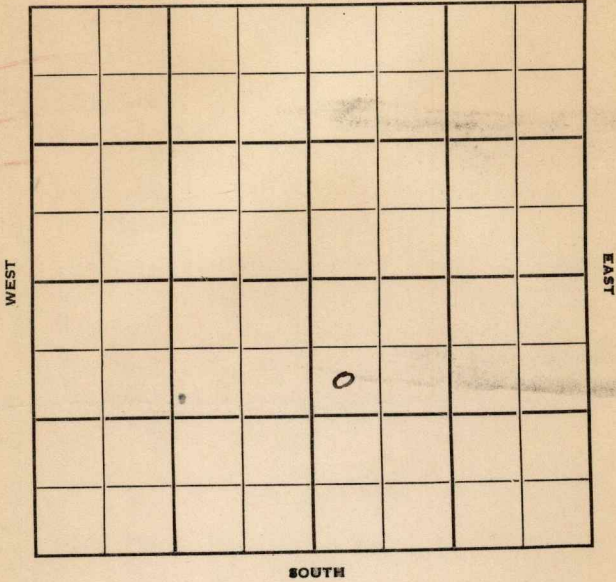


KANAS

Rice

Section 5 Township 19 Range 9WWell No. 5 KellerCompany Sohio et alChase Pool
NORTH

KANSAS

Rice

Sec. 5 Twp. 19 R. 9W **✓**


Well No. #5 Keller Farm

Sohio et al

Company

Chase Pool

NORTH

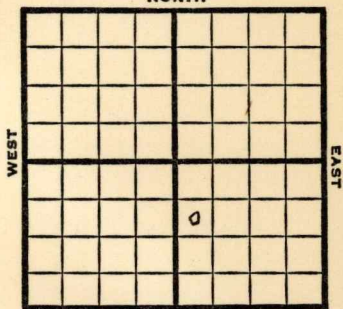

SOUTH

990' Ft. from N. Line

Ft. from S. Line

Ft. from E. Line

330' Ft. from W. Line

SW NW SE

1949

Elev 1717'

REPORT

4/27

8" @ 195'

5/4

Lansing 2892'

Drlg 3000'

5/10

Arb 3247-50'

TD 3250'

5" @ 3248'

5/18

TD 3254

1500 acid

5/25

"

6/1

TD 3276'

Arb. 3247'

5 @ 3248'

Aband.

ABANDONED

Kansas

Map No. _____ Sec. 5 Twp. 19 R. 9WWell No. 5 KellerSohio etal. CompanyFIRST REPORT Contractor

SW NW SE

SECTION PLAT

990 Ft. from N. Line Ft. from S. Line Ft. from E. Line330 Ft. from W. Line

		0	

Rice County

Location _____

Rig up _____

Drilling and Remarks:

8" @ 195

RECORD

Cased _____ in., _____ ft.

Sand _____

Gas _____

Oil _____

Total Depth _____

PRODUCTION

1st 24 hrs. Nat. _____

1st 24 hrs. after shot _____

Gas _____ Cu. Ft.

Dry Hole _____

Abandoned _____

Date


APR 27 1949 19S. J. LEWIS Scout

Kansas

Map No. 149 Sec. 5 Twp. 19 R. 9WWell No. 5 KellerSohio etal. Company**ABANDONED**

Contractor

SW NW SE

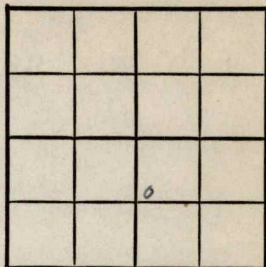E11717
SECTION PLAT990 Ft. from N. Line Ft. from S. Line Ft. from E. Line330 Ft. from W. LineRice CountyLocation Rig up

Drilling and Remarks:

Core 32475" @ 3248**RECORD**Cased in., ft.Sand Gas Oil Total Depth 3276??**PRODUCTION**1st 24 hrs. Nat. 1st 24 hrs. after shot Gas Cu. Ft.Dry Hole Abandoned

Date

JUN 1 1949 19S. J. LEWIS Scout