


Section 6 Township 19 Range 9W

Well No. 2 "A" Haferman (Haferman)
?

Company Shell et al

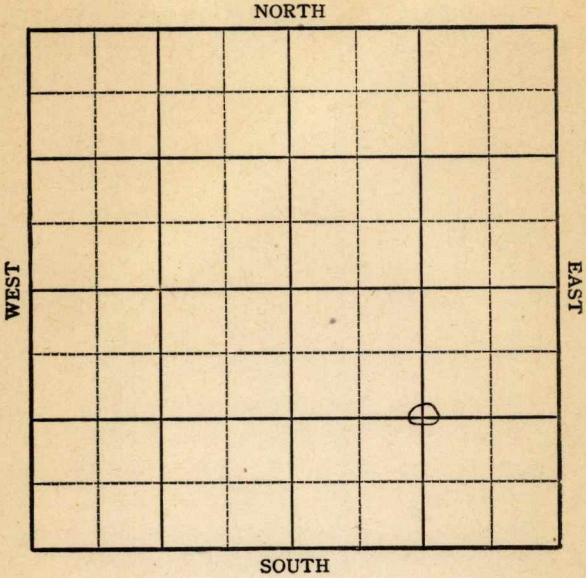



Sec. 6 Twp. 19 R. 9-W

Well No. #2 "A" Haferman Twin Farm

Shell etal Company
Chase


 Ft. from N. Line

1350 Ft. from S. Line

1350 Ft. from E. Line

 Ft. from W. Line

C SE

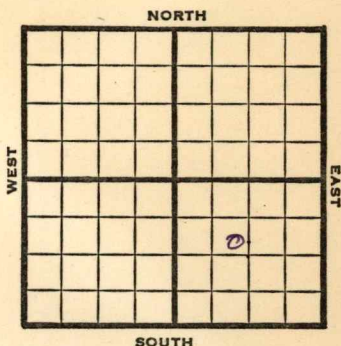

1948 **Eli 1709'** REPORT

8/4 8"@ 151'
WOC

m8/11 **Topeka 2450'**
Drlg 2870'

8/18 **Lansing 2875'**
TD 2961'
4"@ 2957'

8/25 TD 2966' 500 acid
Pump 8 Oil / 50 W 6 hrs.

9/1 **Lansing 2875'**
4"@ 2957'
TD 2966'
500 acid
Pump 53 oil / 332 W Pot
42° Gr.
Comp

COMPLETED

42
O. W. P. B.

S-513-A

CO. ~~Rice~~ ELEV 1709DF
SEC. 6 TWP. 19 RGE. 9W
COMPANY Shell Oil Co. NO. 2-A

FIRST REPORT

DEC 18 57

COMPLETE

FARM Hafermann

O. W. P. B.

(O.W.P.B.)

LOC. C SE app. 1350' fsl x 1350' fel SE/4

Top	2450
Lans	2875
OTD	2966

GEOL. _____

CONTR. _____

POOL Chase-Silica

SPUD _____

OLD INFO: spud 8/1/48,
tops. 4" @ 2957 was Lans
prod. Complete 9/1/48.

NEW INFO: PB 2706,
40/2677-87 Test wtr. &

SSO 2000A P 26 BW no oil 24 hrs. D & A

COMPLETE

CO.
NO.
SEC.
TWP.
RGE.

Rice County Kansas State

Map No. _____ Sec. 6 Twp. 19 R. 9W

Well No. 2 "A" Haferman

Shell etal. Company

FIRST REPORT Contractor

C SE


SECTION PLAT

_____ Ft. from N. Line

1350 Ft. from S. Line

1350 Ft. from E. Line

_____ Ft. from W. Line

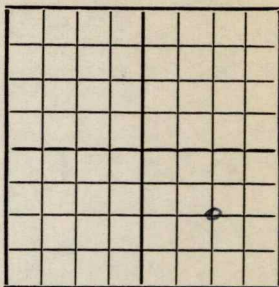

Chase Pool
Remarks:

twin well 8" @ 151 WOC

Misc Small Maps _____
 Cards _____
 Tracing _____
 France Map _____
 Scarborough Map _____
 Pierce Map _____
 Geological Data _____

Date
AUG 4 1948

Scout
S. J. LEWIS

Rice County Kansas State

Map No. 49 Sec. 6 Twp. 19 R. 9W

Well No. 2 "A" Haferman

Shell etal. Company

COMPLETE Contractor

C SE

E1,1709
SECTION PLAT

 Ft. from N. Line

1350 Ft. from S. Line

1350 Ft. from E. Line

 Ft. from W. Line

Chase Pool

Remarks:

Lane 2975


4" @ 2957

7.17.2966

500 acid

Only 53 oil + 932 W. P. X

42° W

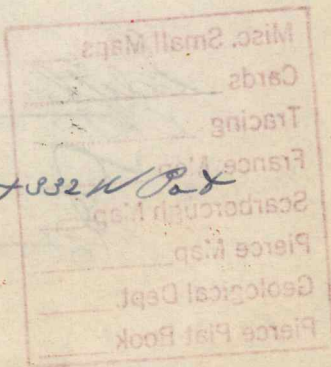

Date
SEP 1 1948

Scout
S. J. LEWIS