

KANSAS

Rice

Section 6 Township 19 Range 9WWell No. #1 SchoonoverCompany Crow Drlg.

Q							

NORTH

WEST

EAST

SOUTH

KANSAS

Rice

Sec. 6 Twp. 19 R. 9W

Well No. #1 Schoonover Farm

Crow Drlg. Company

Chase Pool

Ft. from N. Line

330'


Ft. from S. Line

Ft. from E. Line

330'

Ft. from W. Line

SW NW

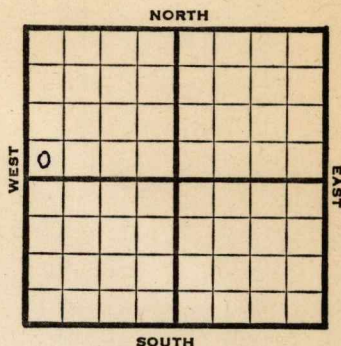

1948

Elev. 1717' REPORT

2/4

8" @ 160'
WOC

2/11

SD

2/18

Drlg 1875'

2/25

Drlg. 3009'

3/3

Lans. 2896'

Arb. 3267'

Total Depth 3272'

ABANDONED

Map No. _____ Sec. 6 Twp. 19 R. 9W


Well No. 1 Schoonover

Crow Drlg. Company

FIRST REPORT Contractor

SW NW

SECTION PLAT

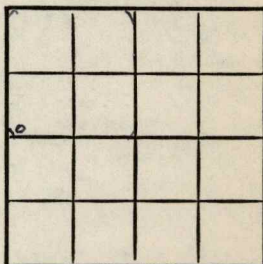

_____ Ft. from N. Line

330 Ft. from S. Line

_____ Ft. from E. Line

330 Ft. from W. Line

Rice County

Location _____

Rig up _____

Drilling and Remarks:

8" @ 160 WD C

RECORD

Cased _____ in., _____ ft.

Sand _____

Gas _____

Oil _____

Total Depth _____

PRODUCTION

1st 24 hrs. Nat. _____

1st 24 hrs. after shot _____

Gas _____ Cu. Ft.

Dry Hole _____

Abandoned _____

Date

FEB 4 1946 19

S. J. LEWIS Scout

Map No. 49 Sec. 6 Twp. 19 R. 9W

Well No. 1 Schoonover

Crow Drlg. Company

ABANDONED Contractor

SW NW


E11712
SECTION PLAT

 Ft. from N. Line

330 Ft. from S. Line

 Ft. from E. Line

330: Ft. from W. Line

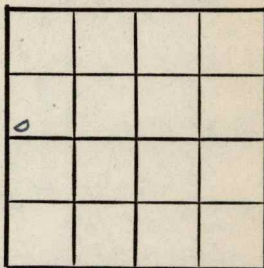

Rice County

Location

Rig up

Drilling and Remarks:

Lease 2896
Ac 8267

RECORD

Cased in., ft.

Sand

Gas

Oil

Total Depth 3222

PRODUCTION

1st 24 hrs. Nat.

1st 24 hrs. after shot

Gas Cu. Ft.

Dry Hole

Abandoned

Date

MAR 3 1948 19

S. J. LEWIS Scout