

U.W.W.O.


KANSAS

Rice

Section 6 Township 19 Range 9-W

Well Number 3 Tobias

Company Shell et al

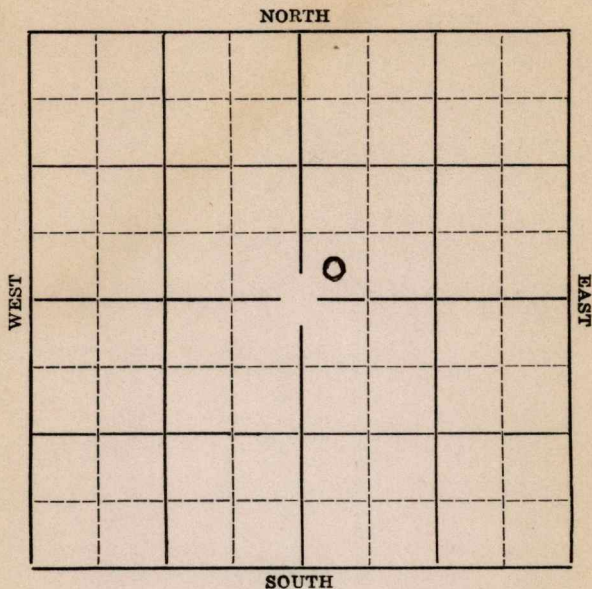

KANSAS

Rice

Sec. 6 Twp. 19 R. 9-WWell No. #3 Tobias FarmShell et al Company

SW SW NE

Ft. from N. Line


330 Ft. from S. Line

Ft. from E. Line

330~~440~~ Ft. from W. Line

Elev. 1710

NORTH

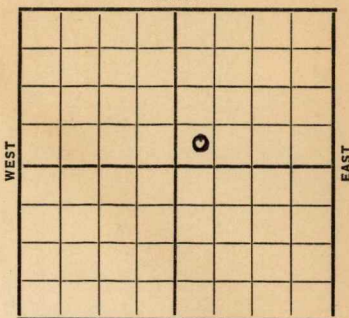

SOUTH

Date	REPORT
1937	
3/17	R O G
3/25	13" @ 147'. WOC.
4/2	Drlg. 1942'.
4/8	Drlg. 3175'
4/16	Sil. 3218'. 7" @ 3219'.
	Drlg. 3337'. 500' oil in
	hole.
4/21	Sil. 3218'.
	T.D. 3340'.
	2000 acid.
	Potential 1696 oil, 110 water
	COMPLETED
	O.W.W.O.
1953	
1/7	Top 2454, Lans 2873, Cong 3195, Arb. 3218
	7" @ 3219
	OTD 3240,
	PB 2706, 32/2672-80 B/1 go
	5 gwph 4 hrs., 1000A
1/15	Testing
1/22	"
1/29	"
2/5	"

OVER

#3 Tobias

O.W.W.O.

1953
2/11

D&A

TD 3240

Top 2454, Lans 2873, Cong
3195, Arb. 3218

7" @ 3219

OTD 3240, PB 2706

32/2672-80k

B/1 go 5 gwph 4 hrs.

1000A P/23 bwpd

D&A

ABANDONED

KANSAS *Rice*Map No. 49 Sec. 6 Twp. 19 R. 9WWell No. 3 TobiasShell & Co Company

Contractor

SECTION PLAT

_____ Ft. from N. Line

330 Ft. from S. Line

_____ Ft. from E. Line

440 Ft. from W. Line**FIRST REPORT**

Location _____

Rig up _____

Drilling and Remarks:

*P.O.G.***RECORD**

Cased _____ in., _____ ft.

Sand _____

Gas _____

Oil _____

Total Depth _____

PRODUCTION

1st 24 hrs. Nat. _____

1st 24 hrs. after shot _____

Gas _____ Cu. Ft.

Dry Hole _____

Abandoned _____

Date

MAR 17 1937

19

S. J. LEWIS

Scout

KANSAS*Rice*Map No. 49 Sec. 6 Twp. 19 R. 9WWell No. 3 TobiasShell Company

Contractor

*correct feet
measurements***SECTION PLAT**

		0	

_____ Ft. from N. Line

330 Ft. from S. Line

_____ Ft. from E. Line

330 Ft. from W. Line**COMPLETED**

Location _____

Rig up _____

Drilling and Remarks:

*Sil 3218**2000 acid**Potential**1696 oil**110 water.***RECORD**

Cased _____ in., _____ ft.

Sand _____

Gas _____

Oil _____

Total Depth 3340**PRODUCTION**

1st 24 hrs. Nat. _____

1st 24 hrs. after shot _____

Gas _____ Cu. Ft.

Dry Hole _____

Abandoned _____

Date

APR 21 1937 19**S. J. LEWIS**

Scout

J. G. McGEHEE


O.W.W.O.

County Rice State Kansas
 Sec. 6 (Blk.) 19 (Sur. Rge.) 9W Map No.

Operator Shell Oil

Well No. 3 Farm Tobias

Elev. 1710 Location SW SW NE

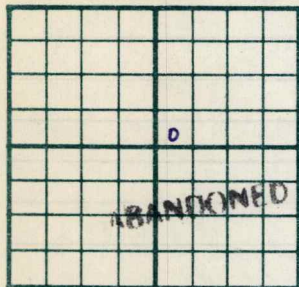

330 Ft. From S Line NE

330 Ft. From W Line Quarter

1st. Report FEB 11 1953

Completion

Remarks OWWO

Spudding Date

Drlg. Data D & A TD 3240

Top. 2454 Lans. 2873 Cong. 3195

Arb. 3218 7" @ 3219 OTD 3240 PB 2706

32/ 2672-80 B/ 1 go 5 gwph 4 hr.

1000 A P/ 23 bwpd

D & A

6281 51 837

