


Section 6 Township 19 Range 9W
Well No. #2 Willard
Company Crow Drlg. etal

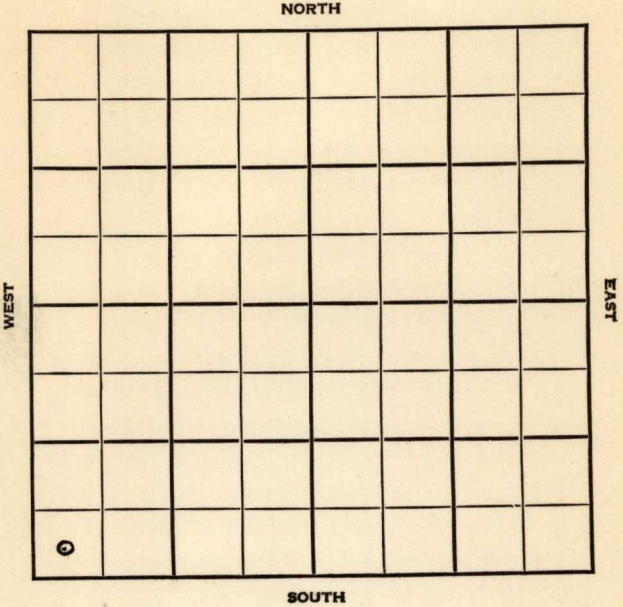

Sec. 6 Twp. 19 R. 9W

Well No. #2 Willard Farm

Crow Drlg. et al Company

Chase


Ft. from N. Line

330 Ft. from S. Line

Ft. from E. Line

330 Ft. from W. Line

SW/C

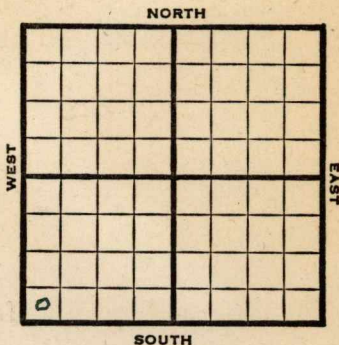

1948

Elev. 1717' REPORT

1/14

8" @ 161'
Drlg. 2910'

1/21

Lansing 2887'
TD 3255 in Conglomerate
No Arbuckle
5" @ 3240'
36 shots 2968-80
2000 Acid

1/26

"

2/4

Cong. 3255'
Lans. 2887'
5" @ 3240'
Perf. Lans.
2000 acid
Depth Pot 1235'
Gr. 42.0
TD 3255'
Comp.

COMPLETED

Map No. _____ Sec. 6 Twp. 19 R. 9W

Well No. 2 Willard

Crow Drlg. etal. Company

FIRST REPORT

Contractor

SW/C

SECTION PLAT

_____ Ft. from N. Line

330 Ft. from S. Line

_____ Ft. from E. Line

330 Ft. from W. Line

Rice County

Location _____

Rig up _____

Drilling and Remarks:

8" @ 161

drlg. 2910

RECORD

Cased _____ in., _____ ft.

Sand _____

Gas _____

Oil _____

Total Depth _____

PRODUCTION

1st 24 hrs. Nat. _____

1st 24 hrs. after shot _____

Gas _____ Cu. Ft.

Dry Hole _____

Abandoned _____

Date

JAN 1 4 1948 19

S. J. LEWIS

Scout

