


Section 7 Township 19 Range 9 W

Well No. # 1 Browning

Company Lewis Drlg.

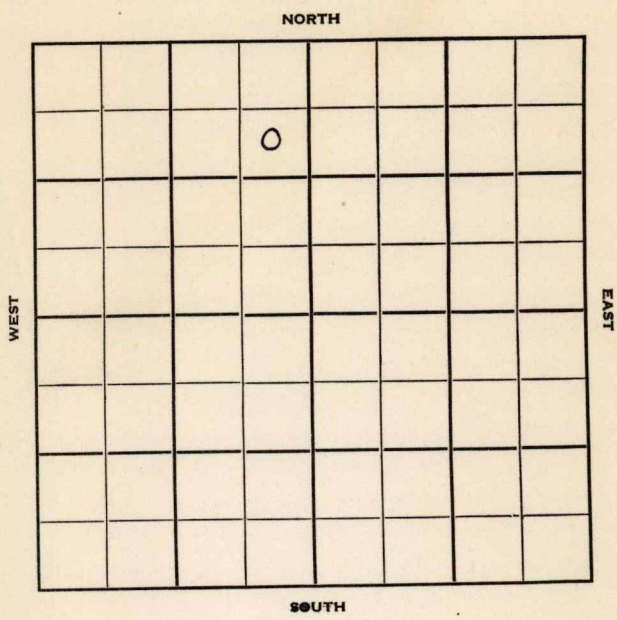

Rice

KANSAS

Sec. 7 Twp. 19 R. 9 W

Well No. # 1 Browning Farm

Lewis Drlg. Company

Lewis Drlg. Contractor


990 Chase Pool
Ft. from N. Line

Ft. from S. Line

330 Ft. from E. Line

Ft. from W. Line

SE NE NW

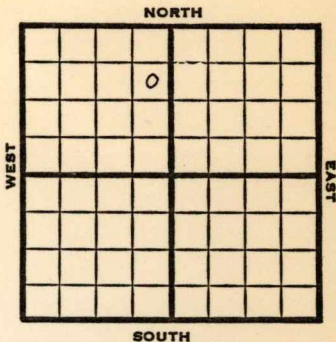

1951

Elev. 1717' REPORT

5/9 Spud 5-4-51
8" @ 168 **Anhy 374'**
Drlg. 2460'

6/13 Spud 5-4-51
Oil well TD 3269' 8" @ 168
Anhy 374' **Lans 2912'** **Arb. 3252'**
SO 3252-58 TD 3269'
DST 3212-69 open 2 hr. 5" @ 3253
CO to 3269 S/3 BOPH
Comp. 60 BOPD

COMPLETED

