


Section 7 Township 19 Range 9W

Well No. #2 Browning

Company Hernderson Oil

NORTH

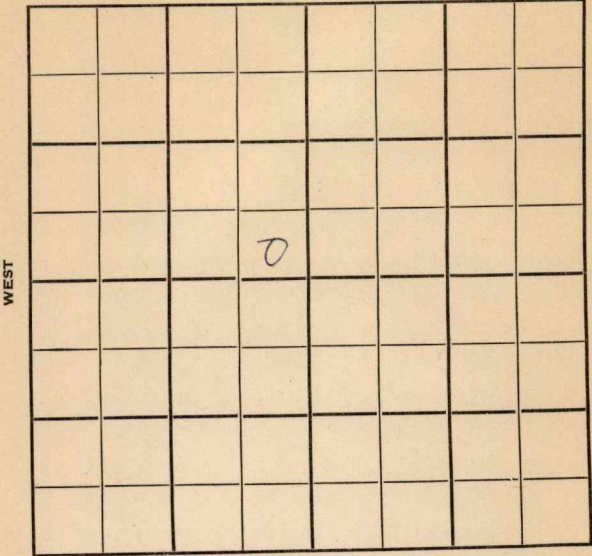

SOUTH

WEST

EAST

Rice

KANSAS

9W ✓

Sec. 7 Twp. 19 R. _____


Well No. #2 Browning Farm _____

Hernderson Oil

Company

Chase Pool (Pickrell Drlg., Contr.)

NORTH

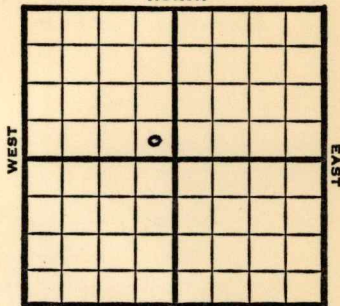

_____ Ft. from N. Line

330' Ft. from S. Line

330' Ft. from E. Line

_____ Ft. from W. Line

SE SE NW

SOUTH

1950

Elev 1722'

REPORT

1/11

MIM

2/1

TD 3298'

8"@ 174'

Heeb 2773'

Br L 2900'

Lans 2924'

Cong 3272'

Arb. 3287-98'

D&A

Aband.

ABANDONED

Kansas

Chase Pool

Map No. _____ Sec. 7 Twp. 19 R. 9W

Well No. 2 Browning

Hernderson Oil Company

Pickrell Drlg. Contractor

SE SE NW

SECTION PLAT

_____ Ft. from N. Line

330 Ft. from S. Line

330 Ft. from E. Line

_____ Ft. from W. Line

FIRST REPORT			
	o		

Rice County

Location _____

Rig up _____

Drilling and Remarks:

M I M

RECORD

Cased _____ in., _____ ft.

Sand _____

Gas _____

Oil _____

Total Depth _____

PRODUCTION

1st 24 hrs. Nat. _____

1st 24 hrs. after shot _____

Gas _____ Cu. Ft.

Dry Hole _____

Abandoned _____

Date

JAN 11 1950 19

J. E. TYRA Scout

Map No. _____ Sec. 7 Twp. 19 R. 9W

Well No. 2 Browning

Henderson Oil Company

Contractor _____

SE SE NW

E. 1722
SECTION PLAT

ABANDONED			

_____ Ft. from N. Line

330 Ft. from S. Line

330 Ft. from E. Line

_____ Ft. from W. Line

Rice County

Location _____

Rig up _____

Drilling and Remarks:

8" @ 174
Sub 2773
BrL 2900
Lens 2924
Conc 3272
and 3287-98

RECORD

Cased _____ in., _____ ft.

Sand _____

Gas _____

Oil _____

Total Depth 3298

PRODUCTION

1st 24 hrs. Nat. _____

1st 24 hrs. after shot _____

Gas _____ Cu. Ft.

Dry Hole _____

Abandoned _____

Date

DFA.

FEB 1 1950

J. E. TYRA