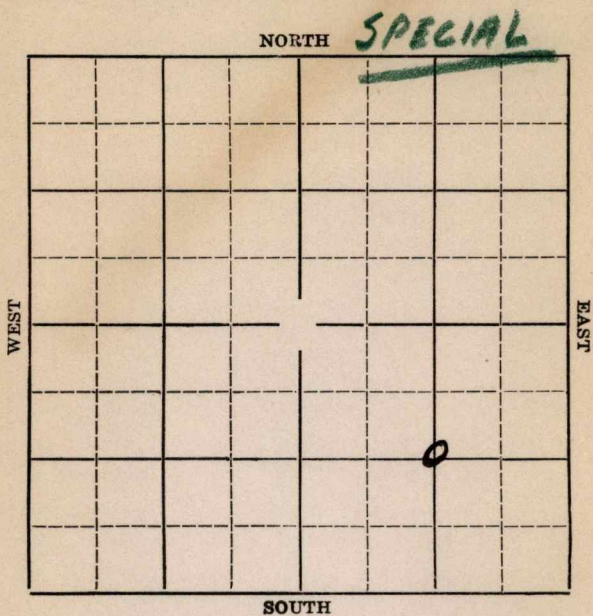


Rice

Section 6 Township 19 Range 9-WWell Number #2-HaffermanCompany Shell Pet. et al


Rice

Map No. KANSAS Sec. 6 Twp. 19 R. 9W

Well No. #2 Hafferman Farm

Shell Petroleum et al Company

NORTH

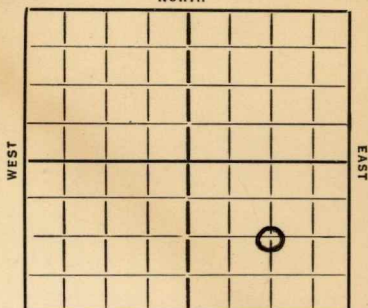

 Ft. from N. Line

1300' Ft. from S. Line

1300' Ft. from E. Line

 Ft. from W. Line

Elev. 1709

1996

O. W. D. R. REPORT SPECIAL

8/5 Rig.

8/13 13" @ 149'. Drlg. 1042'.

8/20 Drlg. 2782'.

8/27 Lansing 2875'. Drlg. 2879'.

9/3 Siliceous 3219'. 7" @ 3220'.

Drlg. 3245'. show of oil.

9/30/36-Sil. 3219'.

T.D. 3270'.

2000 gallons of acid.

Shot 10 qts.

Potential 17 bbls of oil and

5½ bbls of water.

COMPLETED

OVER

1938

O. W. D. D.

1/19

Old T.D. 3270'.

Basal sand 3738'.

Granite wash 3750'.

T.D. 3835'.

Input: 100 bbls. water in 2
hours by gravity.

FIRST REPORTS

and
ABANDONED

KANSAS

Map No. 49 Sec. 6 Twp. 19 R. 9W

Well No. 2 Hafferman

Shell Oil & Gas Company

Contractor

SPECIAL


SECTION PLAT

 Ft. from N. Line

1300 Ft. from S. Line

1300 Ft. from E. Line

 Ft. from W. Line

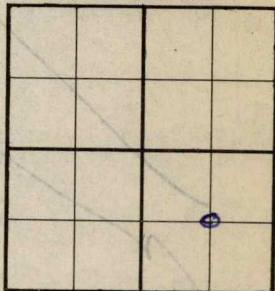

FIRST REPORT

Location

Rig up

Drilling and Remarks:

Rig

RECORD

Cased in., ft.

Sand

Gas

Oil

Total Depth

PRODUCTION

1st 24 hrs. Nat.

1st 24 hrs. after shot

Gas Cu. Ft.

Dry Hole

Abandoned

Date

AUG 5 1936

19


S. J. LEWIS Scout

KANSAS

Map No. 49 Sec. 6 Twp. 19 R. 9WWell No. 2 HaffemanShell Oil Co. Company

Contractor

SECTION PLAT

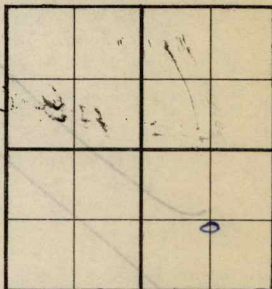

_____ Ft. from N. Line

1300 Ft. from S. Line1300 Ft. from E. Line

_____ Ft. from W. Line

COMPLETED

Location _____

Rig up _____

Drilling and Remarks:

Sil 3219
2000 acid
Br & 10 gts.
Per 17 oil
5 1/2 water

RECORD

Cased _____ in., _____ ft.

Sand _____

Gas _____

Oil _____

Total Depth 3270

PRODUCTION

1st 24 hrs. Nat. _____

1st 24 hrs. after shot _____

Gas _____ Cu. Ft.

Dry Hole _____

Abandoned _____

Date

SEP 30 1936 19 S. J. LEWIS Scout

Rice

KANSASMap No. 48 Sec. 6 Twp. 19 R. 9WWell No. 2 Hafferman

Shell

Company

FIRST REPORT

Contractor

COMPLETED

Approx. C SE

Ft. from N. Line

1300 Ft. from S. Line1300 Ft. from E. Line

Ft. from W. Line

SECTION PLAT

Location _____

Rig up _____

Drilling and Remarks:

OTD 3270

Basal sand 3788

Granite wash 3750

TD 3835

INPUT: 100 bbls
water in 2 hrs
by gravity.**RECORD**

Cased _____ in., _____ ft.

Sand _____

Gas _____

Oil _____

Total Depth 3835**PRODUCTION**

1st 24 hrs. Nat. _____

1st 24 hrs. after shot _____

Gas _____ Cu. _____

Dry Hole _____

Abandoned 3835

Date

JAN 19 1938 19

H. D. Hatfield