


Section..... 6 Township..... 19 Range..... 9-W

Well Number..... 4 Hafferman

Company..... Shell et al

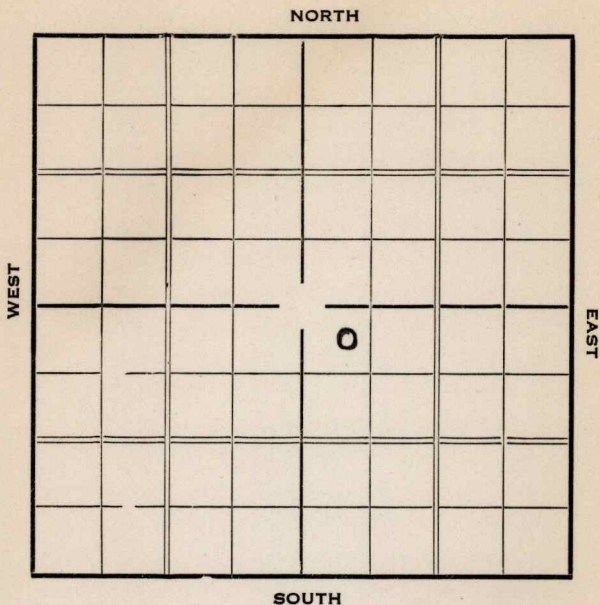

Sec. 6 Twp. 19 R. 9-W

Well No. #4 Hafferman Farm

Shell et al Company


330 Ft. from N. Line

Ft. from S. Line

Ft. from E. Line

440 Ft. from W. Line

Elv. 1716

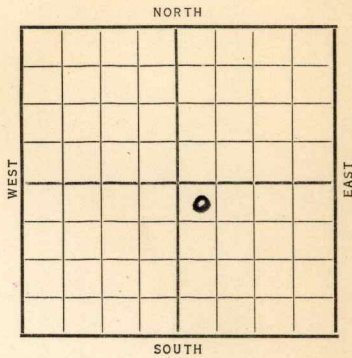

Date	REPORT
1937	
2/10	Rigging up.
2/18	12" @ 147'. Drlg. 220'.
2/26	KCL 2871'. Drlg. 3019'.
3/4	Sil 3206'. 7" @ 3208'
	T.D. 3210' RUST
3/10	Sil. 3206'.
	T. D. 3243'.
	2000 acid.
	Potential 1412.
	COMPLETED

Map No. _____ Sec. 6 Twp. 19 R. 9W

Well No. 4 Hafferman

Shell et al Company

Contractor

SECTION PLAT

		0	

330 Ft. from N. Line

_____ Ft. from S. Line

_____ Ft. from E. Line

440 Ft. from W. Line

FIRST REPORT

Location _____

Rig up _____

Drilling and Remarks:

Rigging up

RECORD

Cased _____ in., _____ ft.

Sand _____

Gas _____

Oil _____

Total Depth _____

PRODUCTION

1st 24 hrs. Nat. _____

1st 24 hrs. after shot _____

Gas _____ Cu. Ft.

Dry Hole _____

Abandoned _____

Date

FEB 10 1937 19

S. J. LEWIS Scout

Map No. _____ Sec. 6 Twp. 19 R. 9W

Well No. 4 Hayferman

Shell et al Company

Contractor _____

SECTION PLAT

		o	

330 Ft. from N. Line

_____ Ft. from S. Line

_____ Ft. from E. Line

440 Ft. from W. Line

COMPLETED

Location _____

Rig up _____

Drilling and Remarks:

*Sil 3206
2000 acid
Potential
1412.*

RECORD

Cased _____ in., _____ ft.

Sand _____

Gas _____

Oil _____

Total Depth 3243

PRODUCTION

1st 24 hrs. Nat. _____

1st 24 hrs. after shot _____

Gas _____ Cu. Ft.

Dry Hole _____

Abandoned _____

Date

MAR 10 1937 19

S. J. LEWIS Scout