


KANSAS

Rice

Form 51—5M—4-36—Palace

Section 6 Township 19 Range 9-WWell Number 1-TobiasCompany Shell

O.W.W.O.

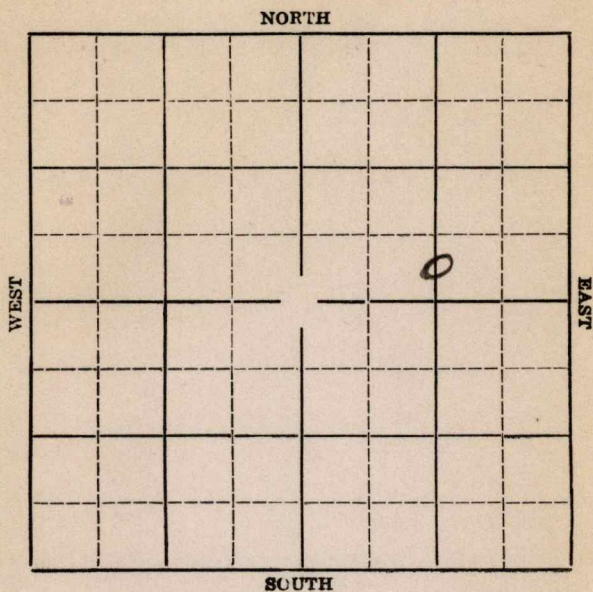

Rice

Map No. **KANSAS** Sec. **6** Twp. **19** R. **9W**

Well No. **#1 Tobias** Farm

Shell

Company

O.W.W.O.


Ft. from N. Line

330' Ft. from S. Line

1320' Ft. from E. Line

Ft. from W. Line

Elev. 1709

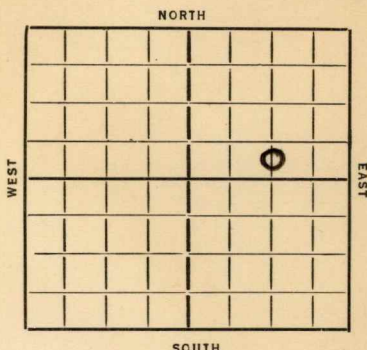

1936

REPORT

6/24 Rig on ground.

7/2 12" @ 152'. Drlg.

7/9 --

7/16 **K.C. 2870'**. Drlg. 2981'.

7/23 3204' fishing pipe.

7/30 **Siliceous 3207'**. TD 3208'. RUST.

8/6 **Siliceous 3207-3226'**. 1000 gallons of acid. Pump 328 bbls. 2000 gallon of acid. Pump 110 bbls in 8 hours.

8/13 3000 gallons of acid. Swab 18 bbls per hour.

8/19/36-Sil. 3207'.

3207-26'-1000 gallons acid.

328 bbls of oil.

3224-38'-3000 gallons of acid.

T.D. 3238'.

Potential 1318'.

COMPLETED

OVER

1950

O.W.W.O.

8/9

KC 2870'

Arb. 3207'

OTD 3238'

7" @ 3206'

PB 3089'

Set 869' of 5" liner

56/2949-64 1000 A P&F/124 B0

279 BWPD Comp.

FIRST REPORT
COMPLETED

KANSAS

Map No. 49 Sec. 6 Twp. 19 R. 9WWell No. 1 TobiasShell Company

Contractor

SECTION PLAT

 Ft. from N. Line330 Ft. from S. Line1320 Ft. from E. Line Ft. from W. Line

FIRST REPORT

Location Rig up

Drilling and Remarks:

ROG

RECORD

Cased in., ft.Sand Gas Oil Total Depth

PRODUCTION

1st 24 hrs. Nat. 1st 24 hrs. after shot Gas Cu. Ft.Dry Hole Abandoned

Date

JUN 24 1936 19

S. J. LEWIS Scout

KANSAS

Map No. 49 Sec. 6 Twp. 19 R. 9WWell No. 1 TobiasShell. Company

Contractor

SECTION PLAT

 Ft. from N. Line820 Ft. from S. Line1820 Ft. from E. Line Ft. from W. Line

COMPLETED

Location Rig up

Drilling and Remarks:

Oil 82078207-26-10000ad328886.8224-88-30000adPS 1318

RECORD

Cased in., ft.Sand Gas Oil Total Depth 3238.

PRODUCTION

1st 24 hrs. Nat. 1st 24 hrs. after shot Gas Cu. Ft.Dry Hole Abandoned

Date

AUG 19 1936

19

S. J. LEWIS

Scout

O.W.W.O.

County Rice State KansasSec. 6 (Blk.) 19 (Sur.) 9W Map No.Operator ShellWell No. 1 Farm TobiasElev. 1709 Location C S L S $\frac{1}{2}$ NE

FIRST REPORT
COMPLETED

330 Ft. From S Line NE1320 Ft. From E Line Quarter1st. Report AUG 9 1950

Completion

Remarks OWWO

Spudding Date

Drlg. Data

Chase Pool

KC 2870 Arb. 3207 OTD 3238 7" @ 3206PB 3089 Set 869' of 5" liner59/ 2949-64 1000 A P & F/ 124 bo279 bwpd Comp.

J. E. TYRA