


Form 51-5M-3-35-Mid-West

Map No. _____ Sec. 6 Twp. 19 R. 9-WWell No. #2-Tobias _____ Farm _____Shell et al _____ Company _____

NORTH

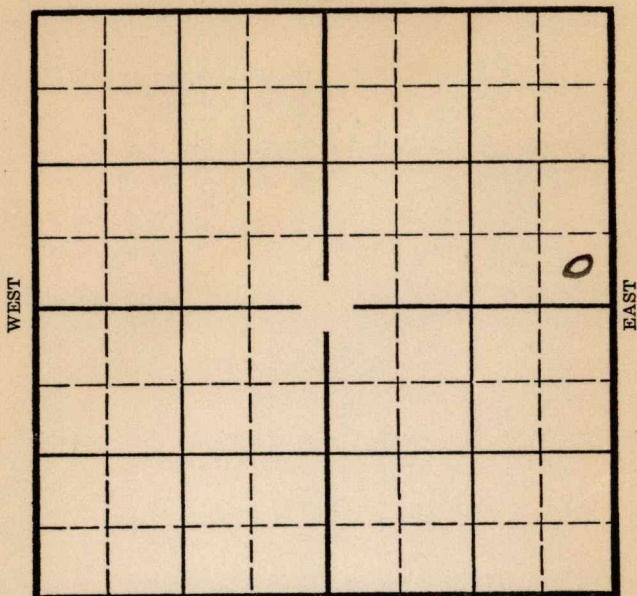

SOUTH

Location _____

Drilling Remarks _____

Rig Up _____

Drilling Remarks _____

RECORD

Cased _____ in. _____ ft.

Sand _____

Gas _____

Oil _____

Total Depth _____

PRODUCTION

1st 24 hrs. Nat. _____

1st 24 hrs. after shot _____


Gas _____ cu. ft. _____

Dry Hole _____

Abandoned _____

Sec. 6 Twp. 19 R. 9-WWell No. #2-Tobias FarmShell et al Company Ft. from N. Line330 Ft. from S. Line330 Ft. from E. Line Ft. from W. Line

Elev. 1711

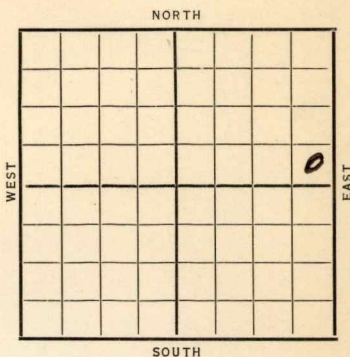Date
1936

REPORT

9/16 Location

9/24 13" @ 161'. WOC.

10-/1 Drlg. 2140'.

10/8 Drlg. 2988&.

10/15 Sil. 3208½'. Pay 3223-27'.

1000' of oil in 5 hours.

10/21/36-¾ Sil. 3208½'.

T.D. 3240'.

2000 gallons of acid.

Potential 1875bbls .

COMPLETED

Rice

KANSAS

Map No. 49 Sec. 6 Twp. 29 R. 9W

Well No. 2 Tobias

Shell & Co. Company

Contractor

SECTION PLAT

			0

Ft. from N. Line

230 Ft. from S. Line

330 Ft. from E. Line

Ft. from W. Line

FIRST REPORT

Location ✓

Rig up

Drilling and Remarks:

RECORD

Cased _____ in., _____ ft.

Sand _____

Gas _____

Oil _____

Total Depth _____

PRODUCTION

1st 24 hrs. Nat. _____

1st 24 hrs. after shot _____

Gas _____ Cu. Ft.

Dry Hole _____

Abandoned _____

Date

SEP 16 1936 19

S. J. LEWIS Scout

KANSASMap No. 49 Sec. 6 Twp. 19 R. 9WWell No. 2 TobiasShell & Co Company

Contractor

SECTION PLAT

Ft. from N. Line

330 Ft. from S. Line330 Ft. from E. Line

Ft. from W. Line

COMPLETED

Location _____

Rig up _____

Drilling and Remarks:

Di 3208 1/22000 acidP 28/1875**RECORD**

Cased _____ in., _____ ft.

Sand _____

Gas _____

Oil _____

Total Depth 3240**PRODUCTION**

1st 24 hrs. Nat. _____

1st 24 hrs. after shot _____

Gas _____ Cu. Ft.

Dry Hole _____

Abandoned _____

Date

OCT 21 1936

19

S. J. LEWIS

Scout