


Section 6 Township 19 Range 9-W

Well No. 1 Pete Weins

Company Duwe & Farris

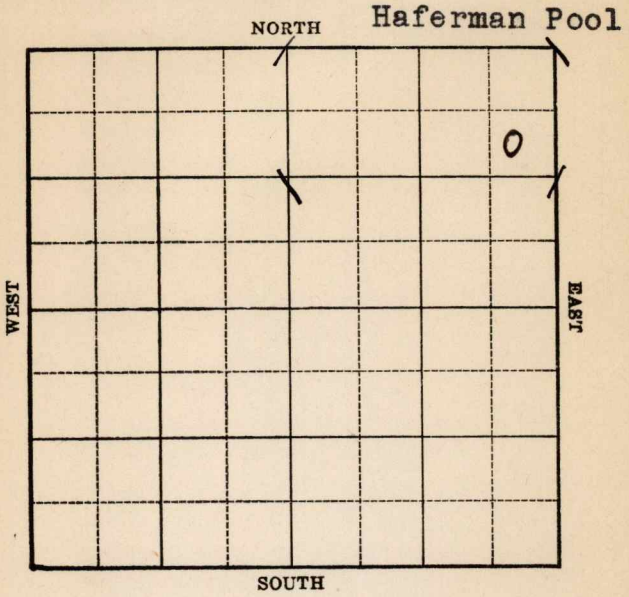

Sec. 6 Twp. 19 R. 9-W

Well No. #1 Pete Weins Farm

Duwe & Farris Company


(Haferman)

990 Ft. from N. Line

_____ Ft. from S. Line

440 Ft. from E. Line

_____ Ft. from W. Line

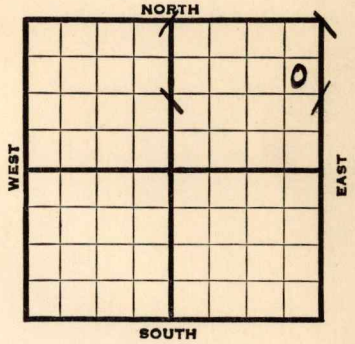

1939	REPORT
3/15	Location
3/24	R.U.R.
3/31	10" - 132' Anhy 362' Drlg. 1892'
4/7	Lans. 2856' Oil stains 2923-28; 2946-50; 2985-90; Drlg. 2995'
4/14	Arb. 3233' S. O. 3237-40' T. D. 3240' 5" - 3234' RUST.
4/21	T. D. 3253' H.F.O. in 7 hours.
4/28	Pump 432 bbls. in 24 hrs. Echometer gauge 428 bbls. Cut 2% water.
5/5	Depthograph gauge 440' fluid. 40% water.
	OVER

1939

5/10

Arb. 3233'

5" - 3234'

T.D. 3240'

Depthograph Potential 440 bbls.
fluid. 25% water.

COMPLETED

Map No. 49 Sec. 6 Twp. 19 R. 9W

Well No. 1 Pete Weins

Duwe & Farris Company

Contractor

FIRST REPORT


990 SE NE NE
Ft. from N. Line

_____ Ft. from S. Line

440 Ft. from E. Line

_____ Ft. from W. Line

SECTION PLAT

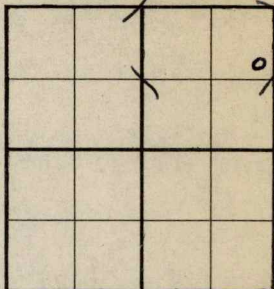

HAFERMAN POOL

Location X

Rig up _____

Drilling and Remarks:

RECORD

Cased _____ in., _____ ft.

Sand _____

Gas _____

Oil _____

Total Depth _____

PRODUCTION

1st 24 hrs. Nat. _____

1st 24 hrs. after shot _____

Gas _____ Cu. Ft.

Dry Hole _____

Abandoned _____

Date

MAR 15 1939

19

H. D. Hatfield Scout

Rice

KANSAS

Map No. 49 Sec. 6 Twp. 19 R. 9W

Well No. 1 Pete Weins

Duwe & Farris Company

Contractor

COMPLETED

SE NE NE

SECTION PLAT

			o

990 Ft. from N. Line

_____ Ft. from S. Line

440 Ft. from E. Line

_____ Ft. from W. Line

HAFERMAN POOL

Location _____

Rig up _____

Drilling and Remarks:

Cell 3233

5" @ 3234

*Depthograph
P & 440 Fluid
25% Water.*

RECORD

Cased _____ in., _____ ft.

Sand _____

Gas _____

Oil _____

Total Depth 3240

PRODUCTION

1st 24 hrs. Nat. _____

1st 24 hrs. after shot _____

Gas _____ Cu. Ft.

Dry Hole _____

Abandoned _____

Date

MAY 10 1939 19

S. J. LEWIS Scout