

KANSAS

Rice

Section 6 Township 19 Range 9W

Well No. #2 Willard

Company Cities Service

Hefferman

NORTH

WEST

EAST

SOUTH

0

Rice

Sec. 6 **KANSAS** Twp. 19 R. 9W

Well No. #2 Willard Farm _____

Cities Service Company

Hefferman

990 Ft. from N. Line


_____ Ft. from S. Line

_____ Ft. from E. Line

330

_____ Ft. from W. Line

SW NW SW

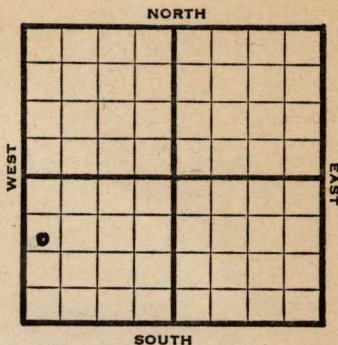

1947

Elev. 1714'

REPORT

10/22

Location

10/29

"

11/5

Surface Hole

11/12

8" @ 260'

Arbuckle 3231'

TD 3234'

5" @ 3231'

RUST

11/19

Lansing 2877'

Arbuckle 3226' corrected

5" @ 3226'

TD 3229'

50 shots 2955-67

Flow 200 bbls oil 16 hrs.

11/25

500 acid.

12/3

Flow 250 bbls oil 8 hrs.

12/10

"

12/23

Arb. 3226'

5" @ 3226'

Lans. 2877' Perf. Lans.

500 acid

Bonus Pot 2901

42.0 Gr.

TD 3226'

COMPLETED

Kansas

Hefferman

Map No. _____ Sec. 6 Twp. 19 R. 9W

Well No. 2 Willard

Cities Service Company

FIRST REPORT Contractor

SW NW SW

SECTION PLAT

990 Ft. from N. Line

_____ Ft. from S. Line

_____ Ft. from E. Line

330 Ft. from W. Line

Rice County

Location X

Rig up _____

Drilling and Remarks:

RECORD

Cased _____ in., _____ ft.

Sand _____

Gas _____

Oil _____

Total Depth _____

PRODUCTION

1st 24 hrs. Nat. _____

1st 24 hrs. after shot _____

Gas _____ Cu. Ft.

Dry Hole _____

Abandoned _____

Date

OCT 22 1947 19

S. J. LEWIS Scout

Map No. 49 Sec. 6 Twp. 19 R. 9W

Well No. 2 Willard

Cities Service Company

COMPLETE

SW NW SW

Contractor

E. I. 1714

SECTION PLAT

990 Ft. from N. Line

_____ Ft. from S. Line

_____ Ft. from E. Line

330 Ft. from W. Line

Rice County

Location _____

Rig up _____

Drilling and Remarks:

PT 3226

5" @ 3226

Leans 2577

Prof Leans

500 acid

Born PT 2901

42 = 91

RECORD

Cased _____ in., _____ ft.

Sand _____

Gas _____

Oil _____

Total Depth 3226

PRODUCTION

1st 24 hrs. Nat. _____

1st 24 hrs. after shot _____

Gas _____ Cu. Ft.

Dry Hole _____

Abandoned _____

Date

DEC 23 1947

19

S. J. LEWIS

Scout