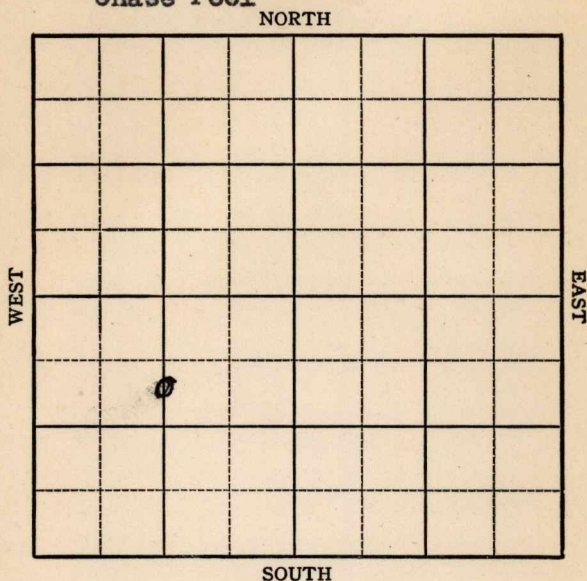


KANSAS

Rice

Section 6 Township 19 Range 9-WWell No. #3 WillardCompany Cities Service
Chase Pool

KANSAS

Rice ✓

Sec. 6 Twp. 19 R. 9W

Well No. 3 Willard Farm

Cities Service

Chase Pool

Contr-Corbett-Barbo Company


825 Ft. from N. Line

 Ft. from S. Line

1320 Ft. from E. Line

 Ft. from W. Line

C S L N $\frac{1}{2}$ SW

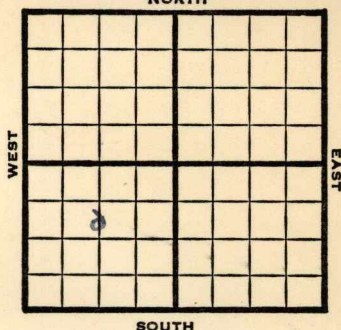

1949

Elev 1713'

R E P O R T

8/24

8" @ 253
Drlg 1255

8/31

Drlg. 3144'

9/7

Lansing 3180'
Arbuckle 3269'

TD 3315'
5" @ 3315'

9/14

TD 3315'
Arb. 3269'
5" @ 3315'
Top 2880'
Perf Top
1000 acid
Flow 134 Oil Pot
42° Gr.
Comp

COMPLETED

Map No. _____ Sec. 6 Twp. 19 R. 9W

Well No. 3 Willard

Cities Service Company

Corbett & Barber Contractor


FIRST REPORT
SECTION PLAT

C S L N $\frac{1}{2}$ SW
825 Ft. from N. Line

_____ Ft. from S. Line

1320 Ft. from E. Line

_____ Ft. from W. Line

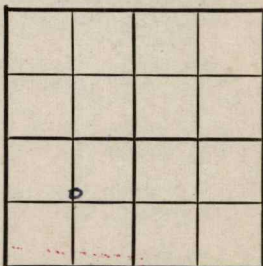

Rice County

Location _____

Rig up _____

Drilling and Remarks:

8" @ 253

dr1g 1255

RECORD

Cased _____ in., _____ ft.

Sand _____

Gas _____

Oil _____

Total Depth _____

PRODUCTION

1st 24 hrs. Nat. _____

1st 24 hrs. after shot _____

Gas _____ Cu. Ft.

Dry Hole _____

Abandoned _____

Date

AUG 24 1949 19 S. J. LEWIS Scout

Kansas


Map No. X 49 Sec. 6 Twp. 19 R. 9WWell No. 3 Willard

Cities Service

Company

COMPLETE

Contractor

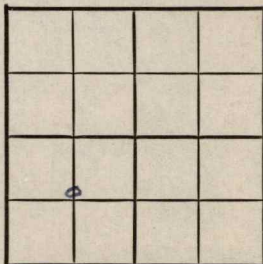C S L N $\frac{1}{2}$ SWF11713
SECTION PLAT825 Ft. from N. Line Ft. from S. Line1320 Ft. from E. Line Ft. from W. Line

Rice County

Location Rig up

Drilling and Remarks:

*See 3269**5" @ 3315.**Nov. 2880**Prof. Nov.**1000 acid**Flow 134 oil (Rt.)**422 lb*

RECORD

Cased in., ft.Sand Gas Oil Total Depth 2315.

PRODUCTION

1st 24 hrs. Nat. 1st 24 hrs. after shot Gas Cu. Ft.Dry Hole Abandoned

Date

SEP 14 1949

19

S. J. LEWIS

Scout