


Rice

Section 7 Township 19 Range 9-W

Well No. 1 Browning

Company Henderson Oil

Hofferma Pool NORTH

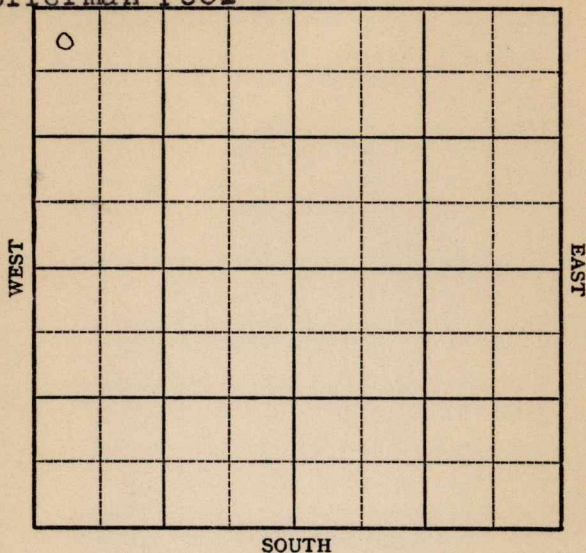

KANSAS

Rice

Sec. 7 Twp. 19 R. 9W

Well No. #1 Browning Farm

Henderson Oil Company

Hofferman


330 Ft. from N. Line

 Ft. from S. Line

 Ft. from E. Line

330 Ft. from W. Line

NW/C

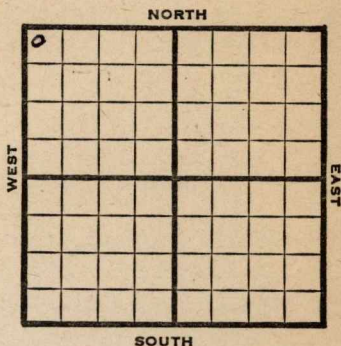

1947 Elev. 1726' REPORT

10/8 RUR

10/15 10" @ 156'
WOC

10/22 Topeka 2487'
Drlg. 2497'

10/29 Lansing 2909'
TD 2970'
3" @ 2970'
RUST

11/5 2987TD

Swb 3 bbls oil & 3 W PH, 12 hrs.

11/12 "

11/16 "

11/25 "

12/3 Lans. 2709'
7" @ 2970'
Pump 50 oil & 50 W Pot
Gr. 41°
Total Depth 2987'

COMPLETED

Map No. _____ Sec. 7 Twp. 19 R. 9W

Well No. 1 Browning

Henderson Oil Company

FIRST REPORT

Contractor

NW/C

SECTION PLAT

0			

330 Ft. from N. Line

_____ Ft. from S. Line

_____ Ft. from E. Line

330 Ft. from W. Line

Rice County

Location _____

Rig up _____

Drilling and Remarks:

R U R

RECORD

Cased _____ in., _____ ft.

Sand _____

Gas _____

Oil _____

Total Depth _____

PRODUCTION

1st 24 hrs. Nat. _____

1st 24 hrs. after shot _____

Gas _____ Cu. Ft.

Dry Hole _____

Abandoned _____

Date

OCT 8 1947 19 S. J. LEWIS Scout

Map No. 49 Sec. 7 Twp. 19 R. 9W

Well No. 1 Browning

Henderson Oil Company

COMPLETE Contractor

NW/C

E41726

SECTION PLAT

0			

330 Ft. from N. Line

_____ Ft. from S. Line

_____ Ft. from E. Line

330 Ft. from W. Line

Rice County

Location _____

Rig up _____

Drilling and Remarks:

Loss 2709

7" C 2970

Run 50 oil + 50W
BT

41 1/2 Gr

RECORD

Cased _____ in., _____ ft.

Sand _____

Gas _____

Oil _____

Total Depth 2987

PRODUCTION

1st 24 hrs. Nat. _____

1st 24 hrs. after shot _____

Gas _____ Cu. Ft.

Dry Hole _____

Abandoned _____

Date

DEC 3 1947

19

S. J. LEWIS

Scout