

Rice


FORM 51

KANSAS

Section 7 Township 19 Range 9W

Well No. #2 Grizzell "B"

Company Lee Phillips

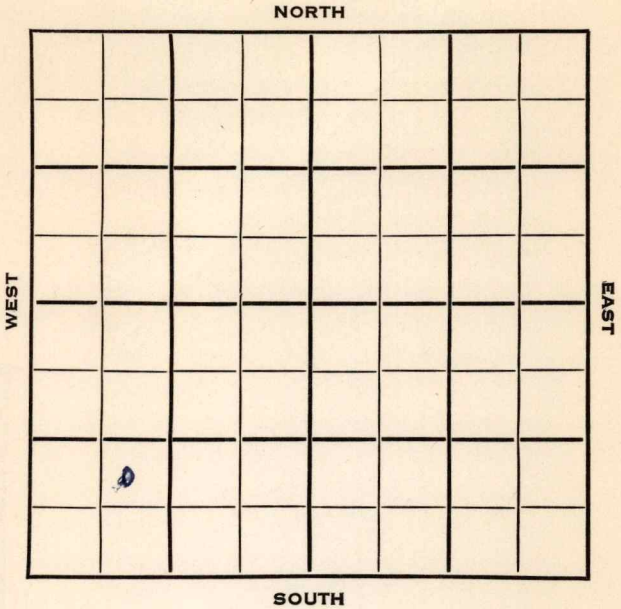

SEC.	TWP.	R.
7	19	9W ✓

WELL NO.

2 Grizzell "B"

FARM

COMPANY

Lee Phillips

CONTRACTOR

Isern Drlg.

Chase-Silica Pool

Ft. from N. Line

990


Ft. from S. Line

Ft. from E. Line

990

Ft. from W. Line

NE SW SW

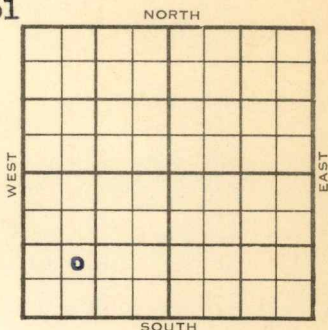

	ELEVATION	REPORT
1954	1742'	

3/3

Spud 2-27-54

8" @ 175'

Anhy 400'

Drlg. 1464'

3/10

Spud 2-27-54

D&A

TD 3291'

8" @ 175'

Anhy 400', Heeb 2785', Br lime 2913',

Lans 2943', Cong 3278', Arb. 3282'

TD 3291'

D&A

ABANDONED

J. G. McGEHEE