


Section 7 Township 19 Range 9W
Well No. 1 Revel
Company Lewis Drlg.

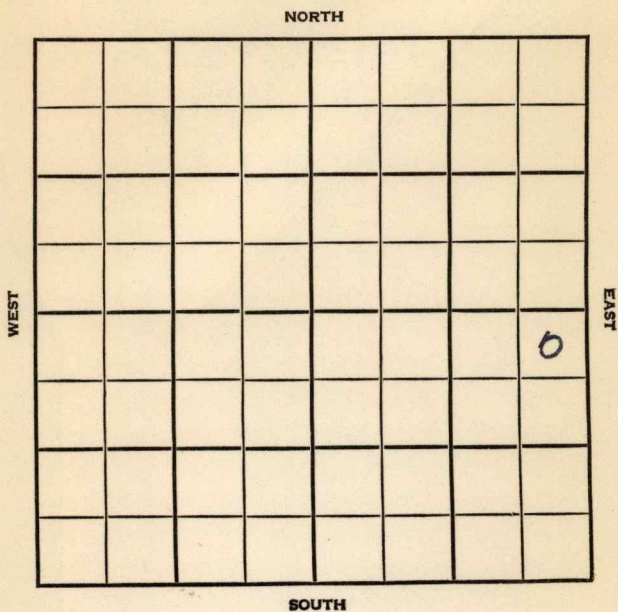

Rice

KANSAS

SEC.	TWP.	R.
7	19	9 W

WELL NO.

1 Revel

FARM

COMPANY

Lewis Drlg.

CONTRACTOR

Co. tools

Chase-Silica Pool


330 Ft. from N. Line

Ft. from S. Line

330 Ft. from E. Line

Ft. from W. Line

NE NE SE

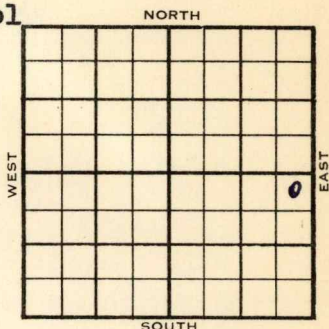

1955

ELEVATION

1714'

REPORT

2/23

Spud 2-12-55

8" @ 152 Heeb 2753' Br. lime 2879'
Lans. 2908'DST 2983-90 open 1 hr rec 80' HO &
GCWM, 600# Arb. 3245'

TD 3248' 5" @ 3246'

3/16

Spud 2-12-55 Oil Well TD 3248

8" @ 152 Heeb 2753, Br Lime
2879, Lans 2908,DST 2983-90 open 1 hr. Rec 80'
HO&GCWM 600# Arb 3245,

TD 3248 5" @ 3246 CO to 3248

S/12 BOPM 24 hr

Comp. 25 BOPD

COMPLETED

Operator Lewis Drlg.

Well No. **1** Farm **Revel**

Elev.	1714	Location	NE NE SE
-------	------	----------	----------

FIRST REPORT 0

330 Ft. From N Line SE

330 Ft. From E Line Quarter

1st. Report FEB 23 1955

Completion

Remarks

Co. tools

Spudding Date **2-12-55**

Drbg. Data Chase-Silica Pool

8" @ 152 Heeb. 2753 Br. lime 2879

Lans. 2908 DST 2983-90 open 1 hr.

Rec. 80' ho & gwm 600# Arb. 3245

TD 3248 5" @ 3246

FABEN GILSTRAP

County Rice State KansasSec. 7 (Blk.
Twp.) 19 (Sur.
Rge.) 9W Map No.Operator Lewis Drlg.Well No. 1 Farm RevelElev. 1714 Location NE NE SE330 Ft. From N Line SE330 Ft. From E Line Quarter

1st. Report

Completion MAR 16 1955Remarks Chase-Silica PoolCo. toolsSpudding Date 2-12-55Drlg. Data Oil well TD 32488" @ 152 Heeb. 2753 Br. lime 2879Lans. 2908 DST 2983-90 open 1 hr.Rec. 80' ho & gcwm 600# Arb. 3245TD 3248 5" @ 3246 CO to 3248S/ 12 boph 24 hr. Comp. 25 bopd

FABEN GILSTRAP