

Section 7 Township 19 Range 9 WWell No. # 1 RevelCompany Morgan-Coleman et al

NORTH

							0

WEST

EAST

SOUTH

Rice

KANSAS

Sec. 7 Twp. 19 R. 9 W ✓

Well No. # 1 Revel Farm

Morgan - Coleman et al Company

Sterling Drlg. Contractor


990 Chase Pool
Ft. from N. Line

_____ Ft. from S. Line

330 Ft. from E. Line

_____ Ft. from W. Line

SE NE SE

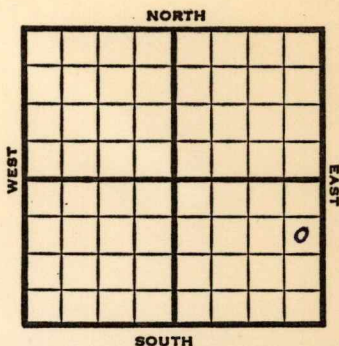

1951

Elev. 1716' REPORT

2/14

Spud 2-9-51
8-5/8" @ 162
Drlg. 1620

3/21

Spud 2-9-51
D&A TD 3244
8-5/8" @ 162'
Heeb. 2745' Br Lime 2881
Lans. 2905'
DST 2983-3008' opn 45 min.
Rec. 135' water & S gas
Arb. 3237
5" @ 3238 TD 3244
1500 A water
D&A
ABANDONED

County Rice State KansasSec. 7 (Blk. 19 (Sur. 9W Map No. 9W)
(Twp.) (Rge.)Operator Morgan - Coleman etal.Well No. 1 Farm RevelElev. _____ Location SE NE SE990 Ft. From N Line SE330 Ft. From E Line Quarter1st. Report FEB 14 1951


Completion _____

Remarks _____

Sterling Drlg. - Contr.Spudding Date 2-9-51Drlg. Data Chase Pool3 5/8" @ 162 drlg. 1620

J. E. TYRA

County Rice State Kansas
 Sec. 7 (Blk.) 19 (Sur.) 9W Map No.
 Operator Morgan - Coleman etal.
 Well No. 1 Farm Revel
 Elev. 1716 Location SE NE SE

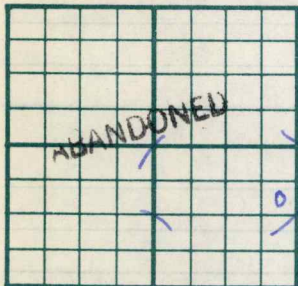

990 Ft. From N Line SE
330 Ft. From E Line Quarter
 Ist. Report
 Completion MAR 21 1951
 Remarks Chase Pool
Sterling Drlg. - Contr.
 Spudding Date 2-9-51

Drlg. Data D & A TD 3244
8 5/8" @ 162 Heeb. 2745 Br. lime 2881
Lans. 2905 DST 2983-3008 open 45 min.
Rec. 135' water & S gas Arb. 3237
5" @ 3238 TD 3244 1500 A water

D & A

J. E. TYRA