

Rice

KANSAS

Section 7 Township 19 Range 9WWell No. #2 SmithCompany Lewis Drlg. Co.

NORTH

						0	

WEST

EAST

SOUTH

Rice

KANSAS

Sec. 7 Twp. 19 R. 9W

Well No. #2 Smith Farm

Lewis Drlg. Co. Company

Lewis Contractor

Chase-Silica


Ft. from N. Line

990 Ft. from S. Line

990 Ft. from E. Line

Ft. from W. Line

NW SE NE

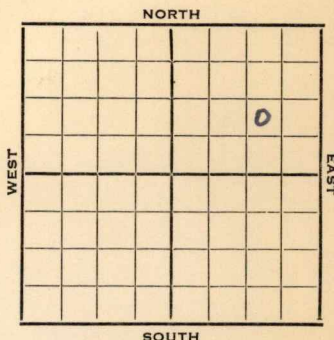

1953

Elev. 1721' REPORT

7/8

Spud 7-1-53

8" @ 158

Hb 2765, BL 2890, KC 2921

Drlg. 2985'

7/15

Spud 7-1-53

D & A TD 3292' 8" @ 158

Heeb 2765 Br lime 2890


KC 2921 Cong. 3244

TD 3292'

D & A

ABANDONED

County Rice State Kansas
 Sec. 7 (Blk.) 19 (Sur.) 9W Map No.
 Operator Lewis Drlg. Co.
 Well No. 2 Farm Smith
 Elev. _____ Location NW SE NE

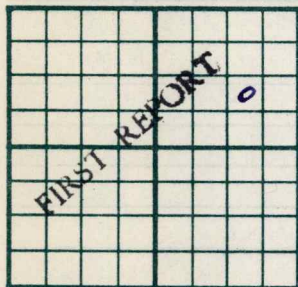

990 Ft. From S Line NE

990 Ft. From E Line Quarter

1st. Report JUL 8 1953

Completion _____

Remarks _____

Lewis - Contr.

Spudding Date 7-1-53

Drlg. Data Chase-Silica

8" @ 158 Hb 2765 BL 2890 KC 2921 Drlg. 2985

J. G. McGEHEE

County Rice State KansasSec. 7 (Blk.
Twp.) 19 (Sur.
Rge.) 9W Map No. Operator Lewis Drlg.Well No. 2 Farm SmithElev. 1721 Location NW SE NE990 Ft. From S Line NE990 Ft. From E Line Quarter1st. ReportCompletion JUL 15 1953Remarks Chase-Silica PoolLewis Drlg. - Contr.Spudding Date 7-1-53Drlg. Data D & A TD 32928" @ 158 Heeb. 2765 Br. lime 2890KC 2921 Cong. 3244 TD 3292D & A