

KANSAS

Form 51—5M—7-40—Palace


Rice

Section 8 Township 19 Range 9-W

Well No. 2 Campbell

Company McPherson Drilling

Chase Pool

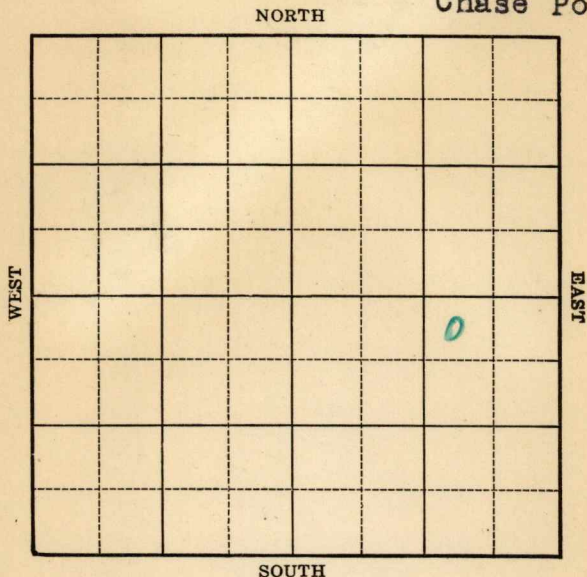

Map No. 49 Sec. 8 Twp. 19 R. 9WWell No. 2 CampbellMcPherson Drilling Company

Contractor

FIRST REPORT

NW NE SE

330 Ft. from N. Line Ft. from S. Line990 Ft. from E. Line Ft. from W. Line

SECTION PLAT

			o

CHASE POOL

Location Rig up

Drilling and Remarks:

Rotary

RECORD

Cased in., ft.Sand Gas Oil Total Depth

PRODUCTION

1st 24 hrs. Nat. 1st 24 hrs. after shot Gas Cu. Ft.Dry Hole Abandoned

Date

JAN 15 1941

19

S. J. LEWIS

Scout

Map No. 49 Sec. 8 Twp. 19 R. 9WWell No. 2 CampbellMcPherson Drilling Company

Contractor

COMPLETED

SECTION PLAT

NW NE SE

330 Ft. from N. Line Ft. from S. Line990 Ft. from E. Line Ft. from W. Line

			0

CHASE POOL

Location Rig up

Drilling and Remarks:

*Cu 8241**5" C 3241**Depth 828000**42 1/2 Gr.*

RECORD

Cased in., ft.Sand Gas Oil Total Depth 3243 1/2

PRODUCTION

1st 24 hrs. Nat. 1st 24 hrs. after shot Gas Cu. Ft.Dry Hole Abandoned

Date

MAR 5 1941 19

S. J. LEWIS Scout