

KANSAS


FORM 51 5M 10-41 PETROL

Rice

Section 8 Township 19 Range 9-W

Well No. #3-Campbell

Company Mcpherson Drlg.

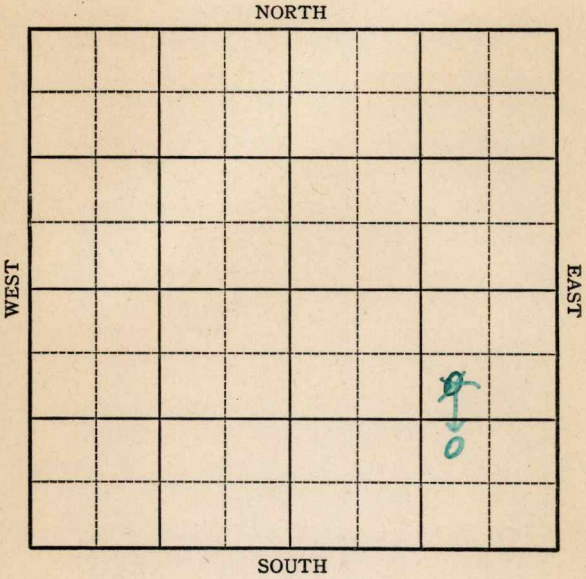


KANSAS

Rice

Sec. 8 Twp. 19 R. 9-WWell No. #3 Campbell FarmMcPherson Drlg. Company

(Chase)

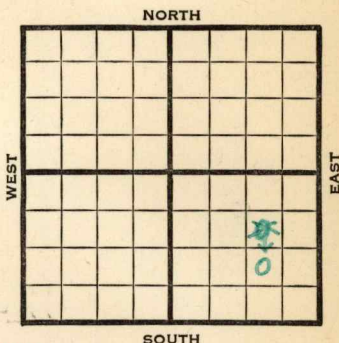990 Ft. from N. Line990 Ft. from S. Line990 Ft. from E. Line Ft. from W. Line

Elev. 1699

1941	REPORT
11/12	Cellar.
11/20	"
11/28	Derrick.
12/4	"
12/11	"
12/18	Drlg. 300
12/24	10" - 323' Drlg. 2625'
12/31	Lans. 2875' Cong. 3181'
	Arb. 3233' 5" - 3233-37' T.D.
	RUST.
1942	
1/8	T.D. 3237' H.F.O.
1/15	" " "
1/21	Arb. 3233'
	5" - 3233'
	T.D. 3237'
	Depthograph potential 2550 bbls.
	43. Gravity
	COMPLETED

Map No. K-49 Sec. 8 Twp. 19 R. 9WWell No. 3 CampbellMcPherson Drlg. CompanyFIRST REPORT Contractor

SW NE SE

990 Ft. from N. Line Ft. from S. Line990 Ft. from E. Line Ft. from W. Line

SECTION PLAT

			o

CHASE POOL

Location Rig up

Drilling and Remarks:

Cellar

RECORD

Cased in., ft.Sand Gas Oil Total Depth

PRODUCTION

1st 24 hrs. Nat. 1st 24 hrs. after shot Gas Cu. Ft.Dry Hole Abandoned

Date

NOV 12 1941

19

S. J. LEWIS

Scout

KANSAS

Map No. H-49 Sec. 8 Twp. 19 R. 9WWell No. 3 CampbellMcPherson Drlg. Company

CORRECTION

Contractor

NW SE SE

 Ft. from N. Line990 Ft. from S. Line990 Ft. from E. Line Ft. from W. Line

SECTION PLAT

			D

CHASE POOL

Location Rig up

Drilling and Remarks:

Reported

SW NE SE

RECORD

Cased in., ft.Sand Gas Oil Total Depth

PRODUCTION

1st 24 hrs. Nat. 1st 24 hrs. after shot Gas Cu. Ft.Dry Hole Abandoned

Date

NOV 19 1941

S. J. LEWIS Scout

Rice

KANSAS

Map No. 49 Sec. 8 Twp. 19 R. 9WWell No. 3 CampbellMcPherson Drilling CompanyCOMPLETED Contractor

NW SE SE

SECTION PLAT

			o

 Ft. from N. Line990 Ft. from S. Line990 Ft. from E. Line Ft. from W. Line

CHASE POOL

RECORD

Location Cased in., ft.Rig up Sand

Drilling and Remarks:

Gas Oil Total Depth 3232

PRODUCTION

1st 24 hrs. Nat. 1st 24 hrs. after shot Gas Cu. Ft.Dry Hole Abandoned

Date

JAN 21 1942 19

S. J. LEWIS Scout

Cr 43233
5" @ 3233
Depth to Pt 2550

43 e by