


Rice

Section 8 Township 19 Range 9-W

Well No. 2 Grizzell "B"

Company McPherson Drilling

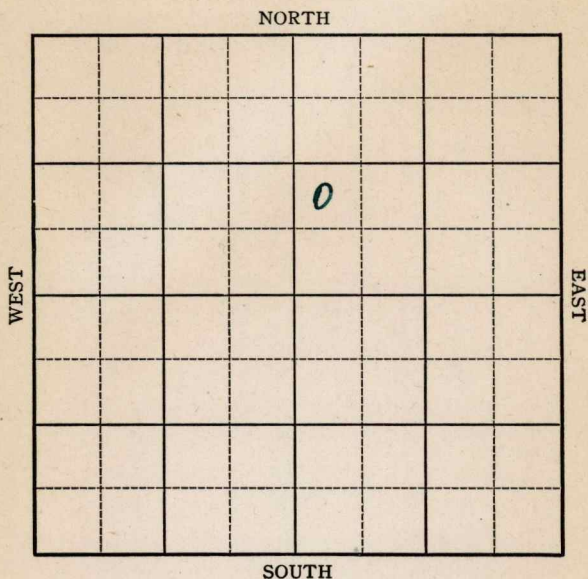

KANSAS


Rice

Sec. 8 Twp. 19 R. 9-WWell No. #2 Grizzell "B" FarmMcPherson Drilling Company

(Chase)

 Ft. from N. Line990 Ft. from S. Line Ft. from E. Line330 Ft. from W. Line

Elev. 1703

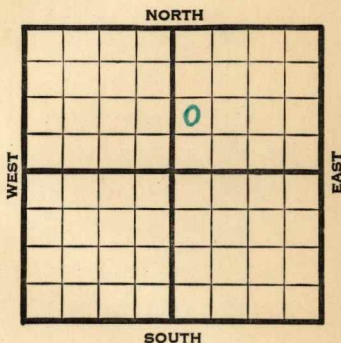

1941

REPORT

7/9 Rotary.

7/17 10" - 160' Drlg. 2200'

7/24 Arby 3230 5" @ 3230 TD RUST

7/31 TD 3237' Flow 200' oil in
10 hrs.

8/6 Arb 3230'

5" @ 3230'

TD 3237'

Maximum 3000

Echo Potential

Gravity 42.6

COMPLETED

Map No. _____ Sec. 8 Twp. 19 R. 9WWell No. 2 Grizzell "B"_____McPherson Drilling_____
Company_____
Contractor

FIRST REPORT

NW SW NE

Ft. from N. Line990 Ft. from S. Line_____
Ft. from E. Line330 Ft. from W. Line

SECTION PLAT

		o	

CHASE POOL

Location _____

Rig up _____

Drilling and Remarks:

Rotary

RECORD

Cased _____ in., _____ ft.

Sand _____

Gas _____

Oil _____

Total Depth _____

PRODUCTION

1st 24 hrs. Nat. _____

1st 24 hrs. after shot _____

Gas _____ Cu. Ft.

Dry Hole _____

Abandoned _____

Date

JUL 9 1941 19S. J. LEWIS Scout

KANSAS

Map No. _____ Sec. 8 Twp. 19 R. 9WWell No. 2 Grizzell "B"McPherson Drilling CompanyCOMPLETED Contractor

NW SW NE

_____ Ft. from N. Line

990 Ft. from S. Line

_____ Ft. from E. Line

330 Ft. from W. Line

CHASE POOL

SECTION PLAT

		o	

Location _____

Rig up _____

Drilling and Remarks:

*Qr 83230**5 @ 3230**Max 3000 Echo**Box**42 6 yr*

RECORD

Cased _____ in., _____ ft.

Sand _____

Gas _____

Oil _____

Total Depth 3232

PRODUCTION

1st 24 hrs. Nat. _____

1st 24 hrs. after shot _____

Gas _____ Cu. Ft.

Dry Hole _____

Abandoned _____

Date

AUG 6 1941

19

S. J. LEWIS Scout