
FORM 51 25M 8-50 WESTERN Rice KANSAS

Section 8 Township 19 Range 9W

Well No. #5 Hutchins

Company Dozier Oil

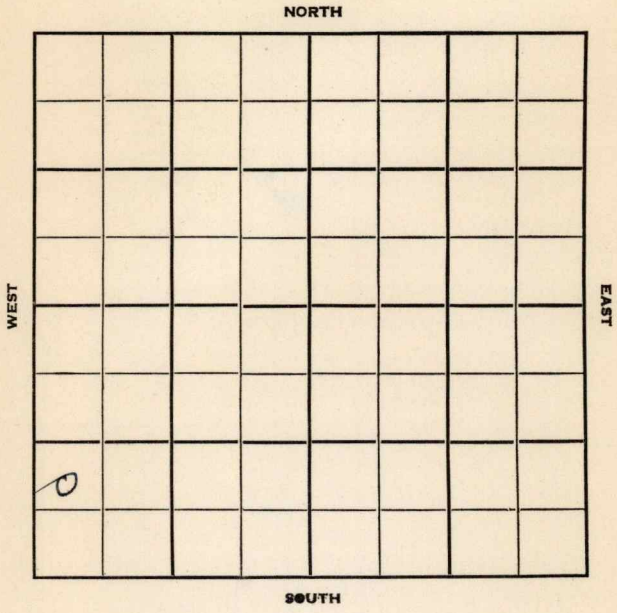

FORM 252-B
10M 10-50 PETROL

Rice KANSAS

Sec. 8 Twp. 19 R. 9W ✓

Well No. #5 Hutchins Farm

Dozier Oil Company

Stagg Drlg. - Contr. Contractor

Chase Pool


____ Ft. from N. Line

990' Ft. from S. Line

____ Ft. from E. Line

330' Ft. from W. Line

NW SW SW

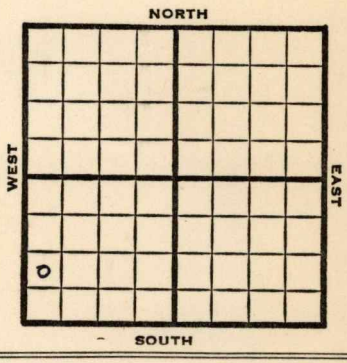

1950	Elev. 1725' REPORT
11/22	Spud 11-19-50 8" @ 147 Drlg. 1224'
12/13	Spud 11-19-50 Oil Well TD 3251 8" @ 147 Heeb. 2757 Br. Lime 2893 Lans. 2908' Arb. 3243-45 5" @ 3243 TD 3251 500 A Comp. 35 bopd COMPLETED

FORM 275 FOR SALE BY KANSAS BLUE PRINT CO.


County Rice State Kansas

Sec. 8 (Blk. Twp.) 19 (Sur. Rge.) 9W Map No.

Operator Dozier Oil

Well No. 5 Farm Hutchins

Elev. 1725 Location NW SW SW

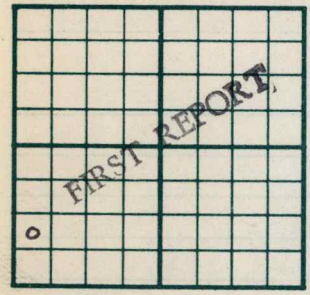

990 Ft. From S Line SW

330 Ft. From W Line Quarter

1st. Report NOV 2 2 1950

Completion

Remarks

Stagg Drlg. - Contr.

Spudding Date 11-19-50

Drlg. Data Chase Pool

8" @ 147 drlg. 1224

J. E. TYRA

FORM 275 FOR SALE BY KANSAS BLUE PRINT CO.


County Rice State Kansas

Sec. 8 (Blk. Twp.) 19 (Sur. Rge.) 9W Map No.

Operator Dozier Oil

Well No. 5 Farm Hutchins

Elev. 1725 Location NW SW SW

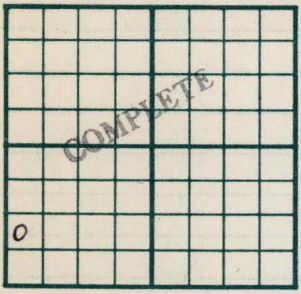

990 Ft. From S Line SW

330 Ft. From W Line Quarter

1st. Report

Completion DEC 1 3 1950

Remarks Chase Pool
Stagg Drlg. - Contr.

Spudding Date 11-19-50

Drlg. Data Oil well TD 3251

8" @ 147 Heeb. 2757 Br. lime 2893

Lans. 2908 Arb. 3243-45 5" @ 3243

TD 3251 500 A Comp. 35 bopd

J. E. TYRA