

Sec. 9 Twp. 19 R. 9-W

Well No. #2 Grizzell Farm

Skelly Oil Company

(Chase Pool)


_____ Ft. from N. Line

330 Ft. from S. Line

990 Ft. from E. Line

_____ Ft. from W. Line

Elev. 1698

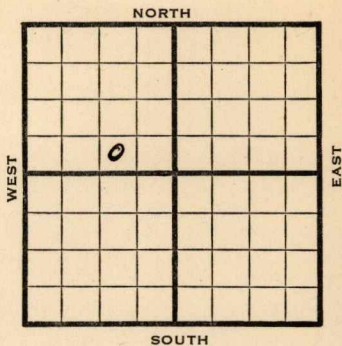

1942

REPORT

8/12

Rotary.

8/19

8" - 256

Drlg. 1475'

8/27

Drlg 3190

9/2

Lans. 2872

Simp. SL 3224

Simp. sd 3235-

Arb. 3239-42 T.D.

5" - 3239 RUST

9/9

" " "

9/23

PB 3240 48 shots 3230 $\frac{1}{2}$ -39 500 acid wtr PB

9/30

TD 3245 Re PB 2937

Perf. 36 shots 2941-42 filled 2500' water 5 hrs. with scum oil

Perf. 2913-33 and 2901-07 - treat 5500 gals - pump 100% water.

10/7

Arb. 3242

5" - 3242

Water

T.D. 3245'

ABANDONED.

Rice

KANSAS

Map No. 49 Sec. 9 Twp. 19 R. 9W

Well No. 2 Grizzell

Skelly Oil Company

ABANDONED Contractor

SW SE NW


SECTION PLAT

 Ft. from N. Line

330 Ft. from S. Line

990 Ft. from E. Line

 Ft. from W. Line

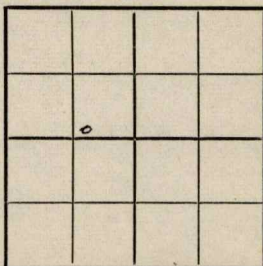

CHASE POOL

Location

Rig up

Drilling and Remarks:

*Cur 83242
5" @ 3242
Notes*

RECORD

Cased in., ft.

Sand

Gas

Oil

Total Depth 3245

PRODUCTION

1st 24 hrs. Nat.

1st 24 hrs. after shot

Gas Cu. Ft.

Dry Hole

Abandoned

Date

OCT 7 1942 19

S. J. LEWIS Scout