


Section 9 Township 19 Range 9-W

Well No. #1 Murphy

Company Cities-Service Oil et al

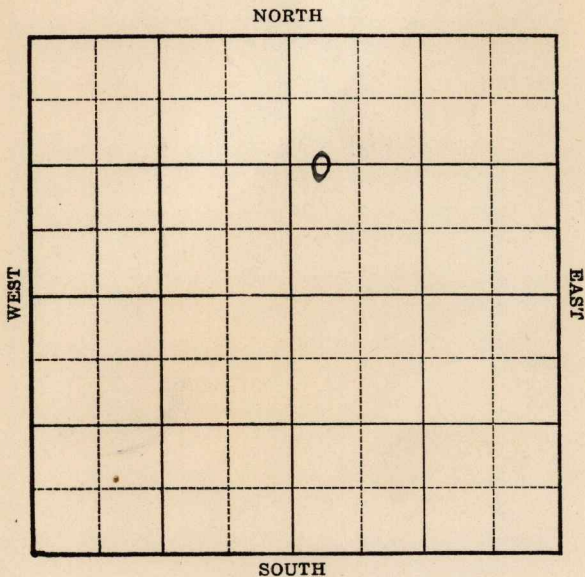

KANSAS

Rice


Sec. 9 Twp. 19 R. 9-WWell No. #1 Murphy FarmCities Service Oil et al Company1320 Ft. from N. Line

Ft. from S. Line

Ft. from E. Line

330 Ft. from W. Line

Elev. 1700

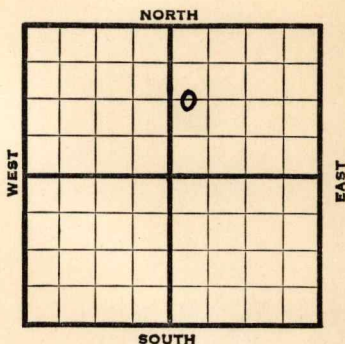

1938

REPORT

11/22

C. R.

12/2

12" - 247'. WOC.

12/9

Drlg. 2016'.

12/15

Lans. 2860'. Drlg. 3190'.

12/21

Arb. 3260'.

T. D. 3265'.

DST open 30 Min.

1250' water.

ABANDONED

Rice

KANSAS

Map No. 49 Sec. 9 Twp. 19 R. 9WWell No. 1 MurphyCities Service Oil ^{ETal} Company

Contractor

FIRST REPORT

C W L NE

1320 Ft. from N. Line

_____ Ft. from S. Line

_____ Ft. from E. Line

330 Ft. from W. Line

SECTION PLAT

		⊙	

Location _____

Rig up _____

Drilling and Remarks:

CR

RECORD

Cased _____ in., _____ ft.

Sand _____

Gas _____

Oil _____

Total Depth _____

PRODUCTION

1st 24 hrs. Nat. _____

1st 24 hrs. after shot _____

Gas _____ Cu. Ft.

Dry Hole _____

Abandoned _____

Date

NOV 22 1938

19

H. D. Hatfield Scout

Rice

KANSAS

Map No. 49 Sec. 9 Twp. 19 R. 9WWell No. 1 Murphy

Cities Service Oil etal Company

ABANDONED

Contractor

SECTION PLAT

C W L N E

1320 Ft. from N. Line

Ft. from S. Line

Ft. from E. Line

330 Ft. from W. Line

		0	

GRAMM NORTH, ARBUCKLE
POOL

Location

RECORD

Cased _____ in., _____ ft.

Sand ARB 3260

Gas _____

Oil _____

Total Depth 3265

PRODUCTION

1st 24 hrs. Nat. _____

1st 24 hrs. after shot _____

Gas _____ Cu. Ft.

Dry Hole _____

Abandoned _____

Date

H. D. Hatfield

DEC 21 1938

19

Scout

D.S.T. open 30 min
1250' WTR

D & A