

Rice


FORM 51 5M 4-41 PETROL

KANSAS

Section 8 Township 19 Range 9-W

Well No. #2 Robins (Robbins)

Company Gulf
(Chase)

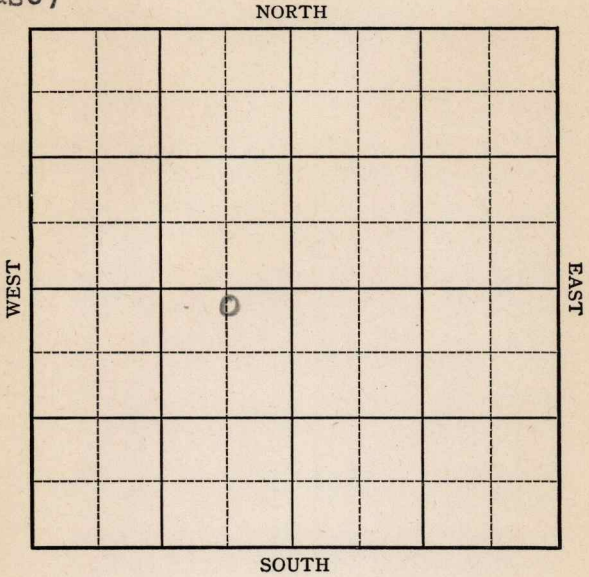


Sec. 8 Twp. 19 R. 9-WWell No. #2 Robins Farm
Gulf Company

(Chase pool)

330 Ft. from N. Line Ft. from S. Line660 Ft. from E. Line Ft. from W. Line

Elev. 1704

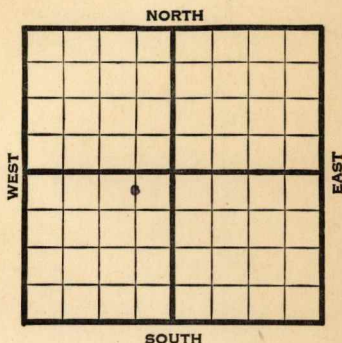

1941

REPORT

8/6 Rotary

8/15 8" - 192' Drlg. 2150'

8/21 Lams. 2890' Arb. 3235-39' T.D.

5" - 3236½' RUST.

8/28 " " "

9/4 T.D. 3249' Swab 30 oil in ~~XX~~ 13
hours.

9/10 Arb. 3235'

5" - 3236½'

T.D. 3249'

2000 acid.

Sonimeter potential 1693 oil &
797 water.

47.5 Gravity

COMPLETED

KANSAS

Map No. _____ Sec. 8 Twp. 19 R. 9W

Well No. 2 Robins

Gulf

Company

FIRST REPORT

Contractor

C N L NE SW

330 Ft. from N. Line

Ft. from S. Line

660 Ft. from E. Line

Ft. from W. Line

SECTION PLAT

	o		

CHASE POOL

Location _____

Rig up _____

Drilling and Remarks:

Rotary

RECORD

Cased _____ in., _____ ft.

Sand _____

Gas _____

Oil _____

Total Depth _____

PRODUCTION

1st 24 hrs. Nat. _____

1st 24 hrs. after shot _____

Gas _____ Cu. Ft.

Dry Hole _____

Abandoned _____

Date

AUG 6 1941

19

S. J. LEWIS

Scout

Map No. _____ Sec. 8 Twp. 19 R. 9WWell No. 2 RobbinsGulf

Company

COMPLETED

Contractor

SECTION PLAT

C N L NE SW

330 Ft. from N. Line

Ft. from S. Line

660 Ft. from E. Line

Ft. from W. Line

CHASE POOL

	o		

Location _____

Rig up _____

Drilling and Remarks:

*Ar 83235**5" @ 3236 1/2**2000 acid**Sonometer Pt**1693 oil + 797 water**475 Gr.*

RECORD

Cased _____ in., _____ ft.

Sand _____

Gas _____

Oil _____

Total Depth 3249

PRODUCTION

1st 24 hrs. Nat. _____

1st 24 hrs. after shot _____

Gas _____ Cu. Ft.

Dry Hole _____

Abandoned _____

Date

SFD 10 1941 19S. J. LEWIS Scout