

KANSAS


Rice

FORM 51 5M 4-41 PETROL

Section 9 Township 19 Range 9 -W

Well No. #1 Grizzell

Company Skelly

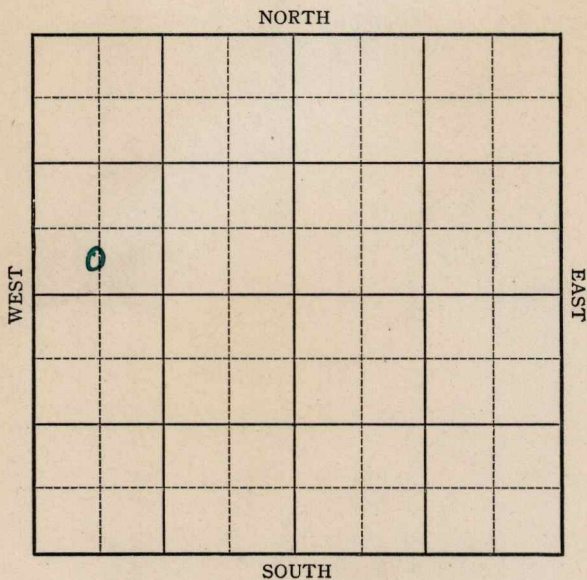


Map No. K-49 Sec. 9 Twp. 19 R. 9WWell No. 1 GrizzellSkelly CompanyFIRST REPORT Contractor

C SL SW NW

 Ft. from N. Line305 Ft. from S. Line Ft. from E. Line620 Ft. from W. Line

CHASE POOL

SECTION PLAT

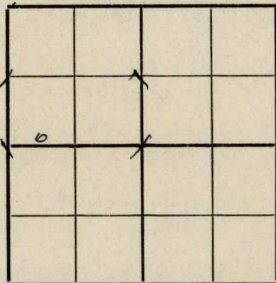Location Rig up

Drilling and Remarks:

Derrick

RECORD

Cased in., ft.Sand Gas Oil Total Depth

PRODUCTION

1st 24 hrs. Nat. 1st 24 hrs. after shot Gas Cu. Ft.Dry Hole Abandoned

Date

SEP 24 1941 19S. J. LEWIS Scout

Map No. 5-49 Sec. 9 Twp. 19 R. 9WWell No. 1 GrizzellSkelly CompanyCOMPLETED Contractor

C SL SW NW

SECTION PLAT

 Ft. from N. Line305 Ft. from S. Line Ft. from E. Line620 Ft. from W. Line

CHASE POOL

Location Rig up

Drilling and Remarks:


RECORD

Cased in., ft.Sand Gas Oil Total Depth 8250

PRODUCTION

1st 24 hrs. Nat. 1st 24 hrs. after shot Gas Cu. Ft.Dry Hole Abandoned

Date

OCT 29 1941

19

S. J. LEWIS Scout