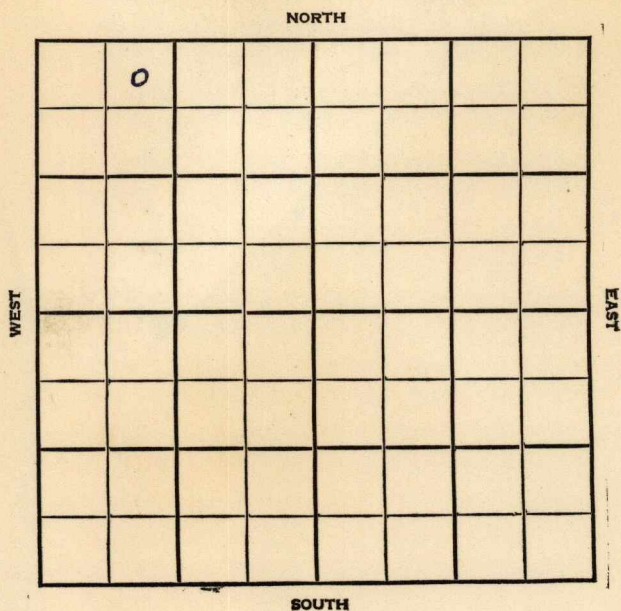


Section 9 Township 19 Range 9WWell No. 1 Grizzell "D"Company Petroleum, Inc.

KANSAS

SEC.	TWP.	R.
9	19	9W

WELL NO.

1 Grizzell "D"

FARM

COMPANY

Petr., Inc.

CONTRACTOR

Garvey

330

Ft. from N. Line

Ft. from S. Line

Ft. from E. Line

990

Ft. from W. Line

NE NW NW

NORTH


SOUTH

1955

ELEVATION

1721'

REPORT

2/2

3/16

Location

Spud 2-1-55 Oil Well TD 3260

8 5/8" @ 168 Anhy 360, Heeb

2739, Br Lime 2868, Lans 2900,

DST 2907-60 open 1 hr gas in 12 min. Rec 180' HOCM, 240' froggy oil, 60' free oil, 600#

DST 2954-81 open 1 hr gas in
43 min., Rec 240' HO&GCM, 120'
free oil, 240' wtr, 650#

В КС 3161

DST 3067-3161 open 1 hr Rec 135'

wtry mud 980# Simp 3245, Arb

3255, DST 3238-59 open 1 hr

Rec 2640' gas 2400' gassy oil,
110' wtr 980#

DST 3243-48 open 1 hr gas in 40 min. Rec 630' froggy oil, 1020' clean oil, 120' wtr.

760# TD 3260 ~~6~~ 5" @ 3256

CO to 3260 FU 3100' fluid 20

min. 2000' in 1 hr 2400' in

2 1/2 hr. 50% wtr S/4.48 B0

82.20 BW 5 hr S/8 B0 85
5 hr Comp 50 BOPD 400 BW

DX-78

COMPLETED

County **Rice** State **Kansas**Sec. **9** (^{Blk.}
Twp.) **19** (^{Sur.}
Rge.) **9W** Map No.Operator **Petroleum Inc.**Well No. **1** Farm **Grizzell "D"**Elev. **1721** Location **NE NW NW**

o							

330 Ft. From **N** Line **NW****990** Ft. From **W** Line **Quarter**1st. Report **FEB 2 1955**

Completion

Remarks

Garvey - Contr.

Spudding Date

Drilg. Data

Location

FABEN GILSTRAP

County Rice State Kansas
 Sec. 9 (Blk. 19) (Sur. 9W) Map No. 19

Operator Petroleum Inc.

Well No. 1 Farm Grizzell "D"

Elev. 1721 Location NE NW NW



330 Ft. From N Line NW

990 Ft. From W Line Quarter

1st. Report

Completion MAR 1 6 1955

Remarks

Stag Drlg. - Contr.

Spudding Date 2-1-55

Drlg. Data Oil well TD 3260

8 5/8" @ 168 Anhy 360 Heeb. 2739

Br. lime 2868 Lans. 2900 DST 2907-60

open 1 hr. gas in 12 min. Rec. 180' hoom

240' froggy oil 60' free oil 600#

DST 2964-81 open 1 hr. gas in 43 min.

Rec. 240' ho & gcm 120' free oil

240' wtr. 650# B KC 3161 DST 3067-3161

open 1 hr. Rec. 135' wtry mud 980#

Simp. 3245 Arb. 3255 DST 3238-59

open 1 hr. Rec. 2640' gas 2400' gassy

oil 110' wtr. 980# DST 3243-48

open 1 hr. gas in 40 min. Rec. 630'

froggy oil 1020' clean oil 120' wtr.

760# TD 3260 5" @ 3256 CO to 3260

FABEN GILSTRAP

OVER

Drlg. Data

FU 3100' fluid 20 min. 2000' in 1 hr.

2400' in $2\frac{1}{2}$ hr. 50% wtr. S/ 4.48 bo

82.20 bw 5 hr. S/ 8 bo 85 bw 5 hr.

Comp. 50 bopd 400 bw

MAR 24 1955

Scout Cards *mmc*

Land Small Map

Land Wall Map

Tracings

France Map

Pierce Map

Misc.