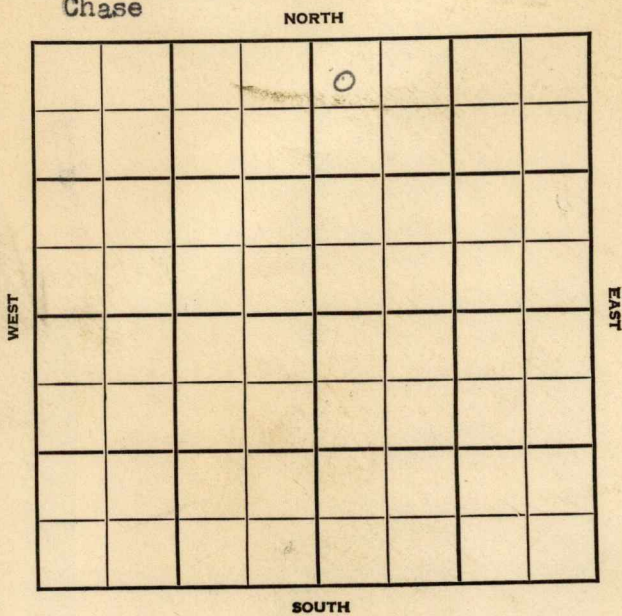


KANSAS

Rice

Section 9 Township 19 Range 9WWell No. #1MurphyCompany Virginia Drlg.
Chase

KANSAS

Rice

Sec. 9 Twp. 19 R. 9W

Well No. #1 Murphy Farm

Virginia Drlg. Company


Chase Pool

330' Ft. from N. Line

Ft. from S. Line

Ft. from E. Line

330' Ft. from W. Line

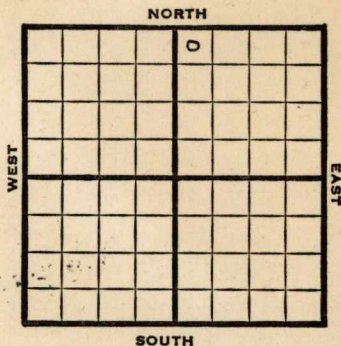

NW NE

1948

Elev. 1705' REPORT

1/7 RUR

1/14 "

1/21 8" @ 185'

Drlg. 1010'

1/28 Lans. 2892'

Cong. 3209'

Arb. 3274'

TD 3282'

Abd.

ABANDONED

Map No. _____ Sec. 9 Twp. 19 R. 9W

Well No. 1 Murphy

Virginia Drlg. Company _____

FIRST REPORT Contractor _____

NW NE


SECTION PLAT

330 Ft. from N. Line

_____ Ft. from S. Line

_____ Ft. from E. Line

330 Ft. from W. Line

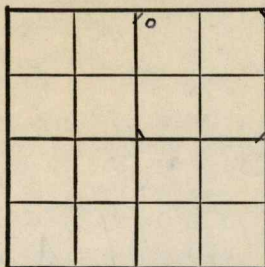

Rice County

Location _____

Rig up _____

Drilling and Remarks:

R U R

RECORD

Cased _____ in., _____ ft.

Sand _____

Gas _____

Oil _____

Total Depth _____

PRODUCTION

1st 24 hrs. Nat. _____

1st 24 hrs. after shot _____

Gas _____ Cu. Ft.

Dry Hole _____

Abandoned _____

Date

JAN 7 1948

19

S. J. LEWIS

Scout

Map No. 49 Sec. 9 Twp. 19 R. 9W

Well No. 1 Murphy

Virginia D. lg.

Company

ABANDONED

Contractor

NW NE

E. 1705

SECTION PLAT

330 Ft. from N. Line

		0	

 Ft. from S. Line

 Ft. from E. Line

330 Ft. from W. Line

Rice County

Location

Rig up

Drilling and Remarks:

*Lease 2892
Comp 8205
CE 43274*

RECORD

Cased in., ft.

Sand

Gas

Oil

Total Depth 3282

PRODUCTION

1st 24 hrs. Nat.

1st 24 hrs. after shot

Gas Cu. Ft.

Dry Hole

Abandoned

Date

JAN 28 1948

19

S. J. LEWIS

Scout