


KANSAS

Rice

Section 9 Township 19 Range 9-W

Well No. #2 Patton "A"

Company McPherson Drlg.

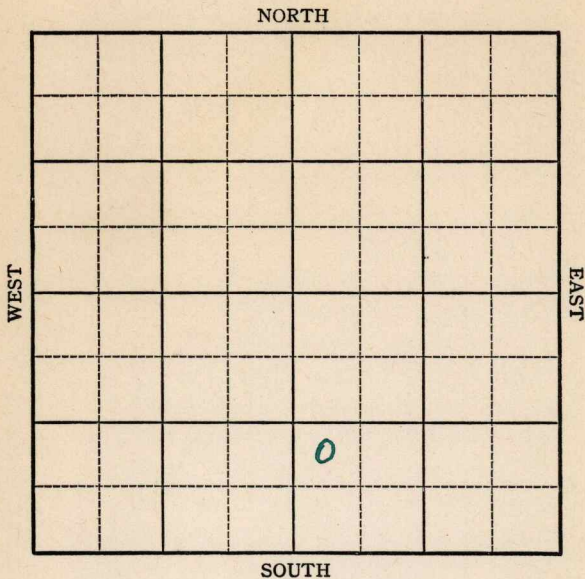

Rice

KANSAS

Map No. K-49 Sec. 9 Twp. 19 R. 9WWell No. 2 Patton "A"McPherson Drlg. CompanyFIRST REPORT Contractor

NW SW SE

SECTION PLAT

 Ft. from N. Line990 Ft. from S. Line Ft. from E. Line330 Ft. from W. Line

		0	

CHASE POOL

Location Rig up

Drilling and Remarks:

Derrick

RECORD

Cased in., ft.Sand Gas Oil Total Depth

PRODUCTION

1st 24 hrs. Nat. 1st 24 hrs. after shot Gas Cu. Ft.Dry Hole Abandoned

Date

NOV 25 1941 19S. J. LEWIS Scout

Map No. 49 Sec. 9 Twp. 19 R. 9WWell No. 2 Patton "A"McPherson Drilling CompanyCOMPLETED Contractor

NW SW SE

SECTION PLAT

 Ft. from N. Line990 Ft. from S. Line Ft. from E. Line330 Ft. from W. Line

CHASE POOL

Location Rig up

Drilling and Remarks:

*Ar Y 3230**5" @ 3230**500 acid**Pump 726 Psd.**425 Gr*

RECORD

Cased in., ft.Sand Gas Oil Total Depth 3233

PRODUCTION

1st 24 hrs. Nat. 1st 24 hrs. after shot Gas Cu. Ft.Dry Hole Abandoned

Date

DEC 23 1941 19S. J. LEWIS Scout