

Section 9 Township 19 Range 9-WWell No. #2 Patton "B"Company McPherson Drilling et al

NORTH Chase Pool

WEST								EAST

0

SOUTH

KANSAS

Rice

Sec. 9 Twp. 19 R. 9-W

Well No. #2 Patton "B" Farm

McPherson Drilling et al Company


(Chase)

Ft. from N. Line

990 Ft. from S. Line

Ft. from E. Line

990
_____ Ft. from W. Line

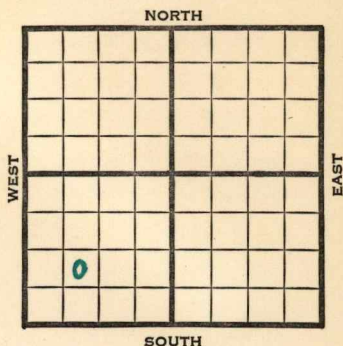

Elev. 1702

[illegible]

Map No. 49 Sec. 9 Twp. 19 R. 9WWell No. 2 Patton "B"McPherson Drilling et al CompanyFIRST REPORT

Contractor

SECTION PLAT

NE SW SW

Ft. from N. Line

990 Ft. from S. Line

Ft. from E. Line

990 Ft. from W. Line

CHASE POOL

Location _____

Rig up _____

Drilling and Remarks:

10" - 121

WOC

RECORD

Cased _____ in., _____ ft.

Sand _____

Gas _____

Oil _____

Total Depth _____

PRODUCTION

1st 24 hrs. Nat. _____

1st 24 hrs. after shot _____

Gas _____ Cu. Ft.

Dry Hole _____

Abandoned _____

Date

MAR 26 194119S. J. LEWIS

Scout

Map No. 49 Sec. 9 Twp. 19 R. 9WWell No. 2 Patton "B"

McPherson Drilling etal Company

COMPLETED

Contractor

SECTION PLAT

NE SW SW

Ft. from N. Line

990 Ft. from S. Line

Ft. from E. Line

990 Ft. from W. Line

CHASE POOL

Location _____

Rig up _____

Drilling and Remarks:

*Ar & 3237**5" @ 3238**1000 acid**Depth 3000**426 gr*

RECORD

Cased _____ in., _____ ft.

Sand _____

Gas _____

Oil _____

Total Depth 3239

PRODUCTION

1st 24 hrs. Nat. _____

1st 24 hrs. after shot _____

Gas _____ Cu. Ft.

Dry Hole _____

Abandoned _____

Date

APR 30 1941 19

S. J. LEWIS

Scout