

KANSAS

Rice


FORM 51 5M 10-41 PETROL

Section 9 Township 19 Range 9-W

Well No. 1 Patton "D"

Company McPherson Drlg.

NORTH Chase Pool

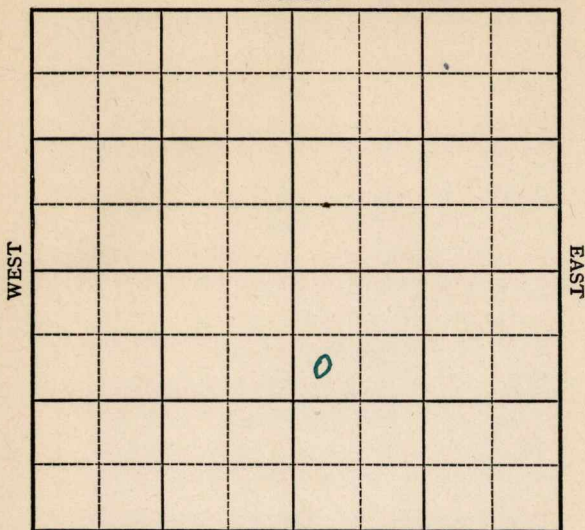

SOUTH

KANSAS

Rice

Sec 9 Twp. 19 R. 9-W

Well No. #1 Patton "D" Farm

McPherson Drlg. Company

(Chase)


990 Ft. from N. Line

 Ft. from S. Line

 Ft. from E. Line

330 Ft. from W. Line

Elev. 1709

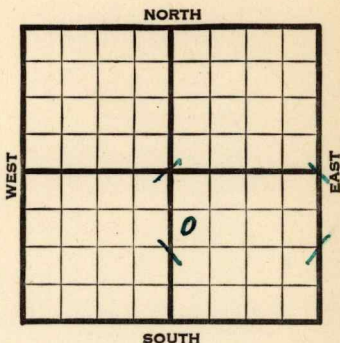

1941	REPORT
12/23	Derriek.
12/31	"
1942	
1/8	SD 160'
1/15	10" - 135' Drlg. 1400'
1/22	Drlg. 2850'
1/29	Lans. 2895' Arb. 3250'
	5" - 3250'
2/5	T.D. 3252' 500 acid. H.F.O.
2/12	" " " "
2/19	" " " "
2/26	" " " "
3/5	" " " "
3/11	Arb. 3250'
	5" - 3250'
	500 acid.
	T.D. 3252'
	Depthograph potential 1977 oil & 659 water. 43.6 Gravity
	COMPLETED

Rice


KANSAS

Map No. 49 Sec. 9 Twp. 19 R. 9WWell No. 1 Patton "D"McPherson Drlg. CompanyFIRST REPORT Contractor

SW NW SE

990 Ft. from N. Line Ft. from S. Line Ft. from E. Line330 Ft. from W. Line

SECTION PLAT

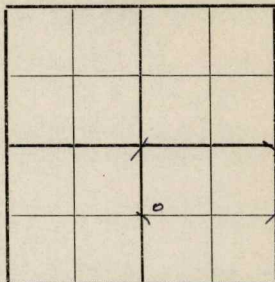

CHASE POOL

Location Rig up

Drilling and Remarks:

Derrick

RECORD

Cased in., ft.Sand Gas Oil Total Depth

PRODUCTION

1st 24 hrs. Nat. 1st 24 hrs. after shot Gas Cu. Ft.Dry Hole Abandoned

Date

DEC 23 1941 19

S. J. LEWIS Scout

Map No. 49 Sec. 9 Twp. 19 R. 9WWell No. 1 Patton "D"McPherson Drilling Company**COMPLETED**

Contractor

SW NW SE

SECTION PLAT

		0	

990 Ft. from N. Line Ft. from S. Line Ft. from E. Line330 Ft. from W. Line

CHASE POOL

RECORD

Location Cased in., ft.Rig up Sand

Drilling and Remarks:

Gas Oil Total Depth 3252

PRODUCTION

1st 24 hrs. Nat. 1st 24 hrs. after shot Gas Cu. Ft.Dry Hole Abandoned Cu x 32505" @ 3250500 acrolDepth to 1977 oil6.59 Water4.36' gas

Date

MAR 1 1 1942

19

S. J. LEWIS Scout