

KANSAS

Rice


Section 10 Township 19 Range 9-W

Well No. #2 Soeken

Company C L Price

Chade Pool

NORTH

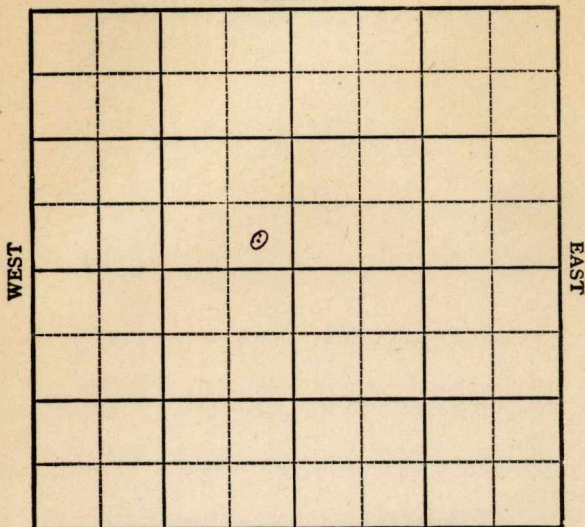

SOUTH

KANSAS Rice



Sec. 10 Twp. 19 R. 9-W

Well No. #2 Soeken Farm

C L Price Company
Chase


 Ft. from N. Line

330 Ft. from S. Line

330 Ft. from E. Line

 Ft. from W. Line

SE NW

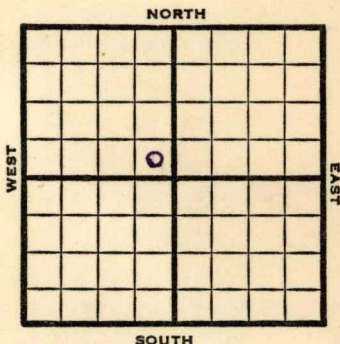

1948	lev 1721' REPORT
10/13	Rig
10/19	"
10/26	"
11/3	"
11/10	"
11/16	"
11/23	"
11/30	"
12/6	"
12/15	"
12/22	"
12/29	"
1/5	"
1/12	"
1/19	"
1/26	"
2/2	"
2/9	"
2/16	"
2/23	"
3/2	"
3/9	Location
	Aband.
	ABANDONED

Map No. _____ Sec. 10 Twp. 19 R. 9W

Well No. 2 Soeken

C. L. Price Company

FIRST REPORT

Contractor

SE NW

SECTION PLAT

_____ Ft. from N. Line

330 Ft. from S. Line

330 Ft. from E. Line

_____ Ft. from W. Line

Rice County

Location _____

Rig up _____

Drilling and Remarks:

Rig

RECORD

Cased _____ in., _____ ft.

Sand _____

Gas _____

Oil _____

Total Depth _____

PRODUCTION

1st 24 hrs. Nat. _____

1st 24 hrs. after shot _____

Gas _____ Cu. Ft.

Dry Hole _____

Abandoned _____

Date

OCT 13 1948 19

S. J. LEWIS Scout

Kansas

Chase Pool

Map No. _____ Sec. 10 Twp. 19 R. 9WWell No. 2 Soeken

C. L. Price

Company

ABANDONED

Contractor


SE NW

E/1721
SECTION PLAT

_____ Ft. from N. Line

330 Ft. from S. Line330 Ft. from E. Line

_____ Ft. from W. Line

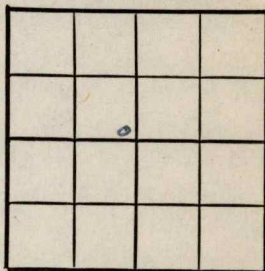

Rice County

Location ✓

Rig up _____

Drilling and Remarks:

RECORD

Cased _____ in., _____ ft.

Sand _____

Gas _____

Oil _____

Total Depth _____

PRODUCTION

1st 24 hrs. Nat. _____

1st 24 hrs. after shot _____

Gas _____ Cu. Ft.

Dry Hole _____

Abandoned _____

Date

MAR 9 1949

19

S. J. LEWIS

Scout