


Section 10 Township 19 Range 9 W

Well No. # 1 Soeken "A"

Company Earl Wakefield & Skiles

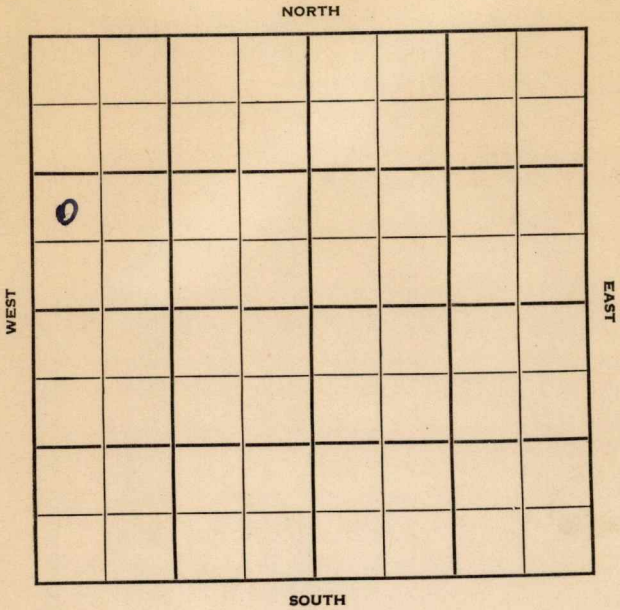

Rice

KANSAS

Sec. 10 Twp. 19 R. 9W

Well No. #1 Soeken "A" Farm

Earl Wakefield & Skiles Company

Wakefield Contractor


 Ft. from N. Line

990 Ft. from S. Line

 Ft. from E. Line

330 Ft. from W. Line

NW SW NW

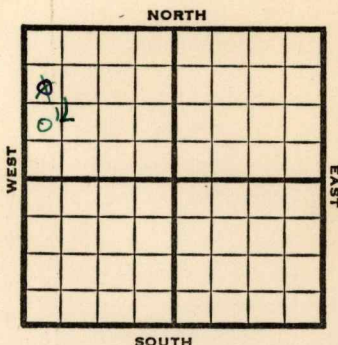

1952 Elev. 1706' REPORT

9/4 Spud 8-26-52
15" @ 53'
Anhy 346' 13" @ 349'
Drlg. 1010'

9/10 Drlg. 1720'
9/17 10" @ 1770'
Drlg. 1935'

9/24 8" @ 2205 Drlg. 2740'

10/1 Lans 2882' 7" @ 2982'
Drlg. 3160'

10/8 Spud 8-26-52
D&A TD 3276' 15" @ 53'
Anhy 346 13" @ 349'
10" @ 1170' 8" @ 2205
Lans. 2882 7" @ 2982
Cong. 3202 Arb. 3276
TD 3276' D&A


ABANDONED

County	Rice		State	Kansas	
Sec.	10	(Blk. Twp.)	19	(Sur. Rge.)	9W Map No.
Operator	Earl Wakefield & Skiles				
Well No.	1	Farm	Soeken "A"		
Elev.			Location	NW SW NW	
			990 Ft. From	S	Line NW
			330 Ft. From	W	Line Quarter
			1st. Report	SEP	4 1952
			Completion		
			Remarks	Wakefield - Contr.	
			Spudding Date	8-26-52	

Drlg. Data

15" @ 53 Anhy 346 13" @ 349 drlg. 1010

County Rice State Kansas
 Sec. 10 (Blk.
Twp.) 19 (Sur.
Rge.) 9W Map No.
 Operator Earl Wakefield & Skiles
 Well No. 1 Farm Soeken "A"
 Elev. 1706 Location NW SW NW

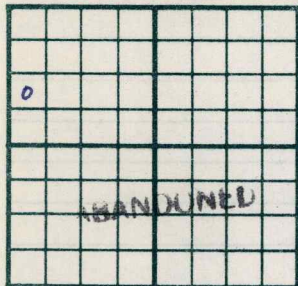

990 Ft. From S Line NW
330 Ft. From W Line Quarter
 1st. Report
 Completion OCT 8 1952
 Remarks Wakefield - Contr.
 Spudding Date 8-26-52

Drlg. Data D & A TD 3276
15" @ 53 Anhy 346 13" @ 349
10" @ 1770 8" @ 2205 Lens. 2882
7" @ 2982 Cong. 3202 Arb. 3276
TD 3276

D & A