


Section 10 Township 19 Range 9 W

Well No. # 1 Colberg

Company J. Bergman

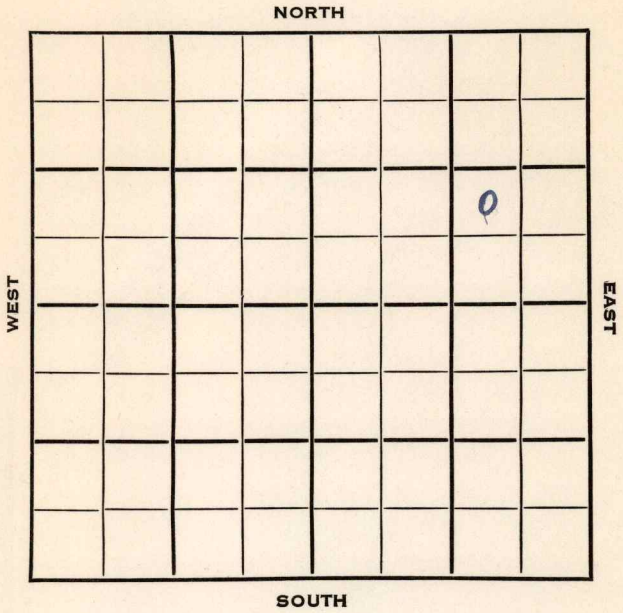

Rice

KANSAS

SEC.	TWP.	R.
10	19	9 W ✓

WELL NO.

COMPANY	# 1 Colberg	FARM
---------	-------------	------

CONTRACTOR	J. Bergman
------------	------------

	Schafer
--	---------


_____ Ft. from N. Line

990 _____ Ft. from S. Line

990 _____ Ft. from E. Line

_____ Ft. from W. Line

NW SE NE

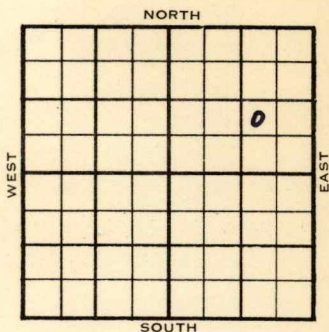

1953	ELEVATION 1722'	REPORT
------	--------------------	--------

10/14	MIR
10/21	8" @ 126 Anhy 365 Drlg. 2942'
10/28	RTD 3345' 5" @ 3344'
11/4	40/3300-3310, S/2 $\frac{1}{4}$ BOPH
11/11	Spud 10-13-53 Oil well TD 3345' 8" @ 126 Anhy 365 Br lime 2870 Lans 2898' DST 2902-42, open 1 hr rec 600' gas, 120' O & GCM 215# Cong 3221' Simp. 3296 DST 3298-3314 open 1 hr rec 185' oil 900# TD 3345' 5" @ 3344 40/3300- 10 S/2 $\frac{1}{4}$ BOPH Arb. 3340' Comp. 50 BOPD

COMPLETED

County Rice State Kansas

Sec. 10 (Blk. 19) (Sur. 9W) (Twp.) (Rge.) Map No.

Operator J. Bergman

Well No. 1 Farm Colberg

Elev. _____ Location NW SE NE



990 Ft. From S Line NE

990 Ft. From E Line Quarter

1st. Report OCT 14 1953

Completion _____

Remarks _____

Schafer - Contr.

Spudding Date _____

Drlg. Data

M I R

County Rice State Kansas

Sec. 10 (Blk. (Twp.)) 19 (Sur. Rge.) 9W Map No.

Operator J. Bergman

Well No. 1 Farm Colberg

Elev. 1722 Location NW SE NE



990 Ft. From S Line NE
990 Ft. From E Line Quarter

1st. Report

Completion NOV 11 1953

Remarks

Schafer - Contr.

Spudding Date 10-13-53

Drilg. Data Oil well TD 3345

8" @ 126 Anhy 365 Br. lime 2870

Lans. 2898 DST 2902-42 open 1 hr.

Rec. 600' gas 120' o & gcm 215 #

Cong. 3221 Simp. 3296 DST 3298-3314

open 1 hr. Rec. 185' oil 900#

TD 3345 5" @ 3344 40/ 3300-10

S/ 2 1/4 boph Arb. 3340

Comp. 50 bopd