

KANSAS


Form 51-5M-7-39-Palace

Rice

Section 10 Township 19 Range 9-W

Well No. #1 Cramm "B"

Company McPherson Drilling

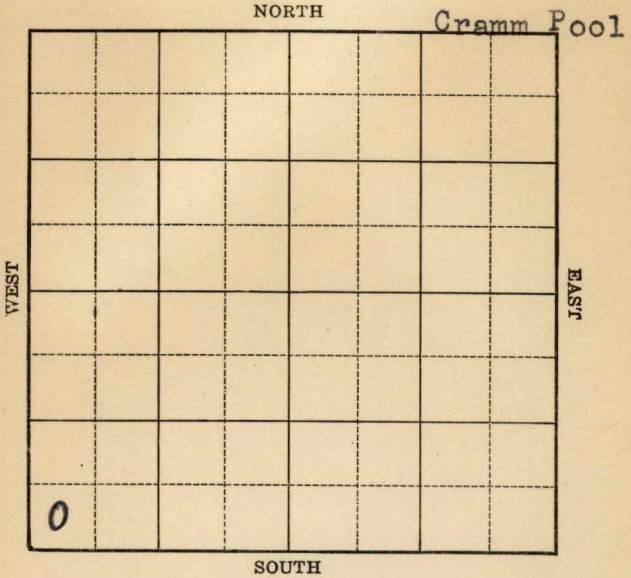

Sec. 10 Twp. 19 R. 9-W

Well No. #1 Cramm "B" Farm \_\_\_\_\_

McPherson Drilling Company \_\_\_\_\_

(Cramm)


\_\_\_\_\_ Ft. from N. Line

330 Ft. from S. Line

\_\_\_\_\_ Ft. from E. Line

330 Ft. from W. Line

Elev. 1700

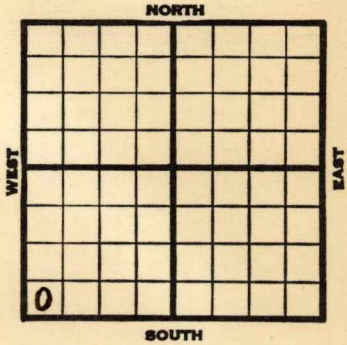

1939	REPORT
10/18	10" - 129' WOC.
10/26	Drlg. 450'
11/2	Arb. 3197' 7" - 3197'
	T.D. 3208' RUST.
11/9	" " "
11/16	T.D. 3211' H.F.O.
11/23	1000 acid. Pump 72 bbls. 8 hrs.
11/29	Shut down.
12/7	2000 acid. Drill deeper.
12/14	" " " " "
12/20	Arb. 3197'
	7" - 3197'
	T.D. 3211'
	3000 acid.
	Depthograph potential 756 bbls.
	<b>COMPLETED</b>

Rice

KANSAS

Map No. 49 Sec. 10 Twp. 19 R. 9W

Well No. 1 Cramm "B"

McPherson Drilling Company

Contractor

FIRST REPORT

SW/C

SECTION PLAT


\_\_\_\_\_ Ft. from N. Line

330 Ft. from S. Line

\_\_\_\_\_ Ft. from E. Line

330 Ft. from W. Line

CRAMM POOL

Location \_\_\_\_\_

Rig up \_\_\_\_\_

Drilling and Remarks:

10" - 129

WOC

RECORD

Cased \_\_\_\_\_ in., \_\_\_\_\_ ft.

Sand \_\_\_\_\_

Gas \_\_\_\_\_

Oil \_\_\_\_\_

Total Depth \_\_\_\_\_

PRODUCTION

1st 24 hrs. Nat. \_\_\_\_\_

1st 24 hrs. after shot \_\_\_\_\_

Gas \_\_\_\_\_ Cu. Ft.

Dry Hole \_\_\_\_\_

Abandoned \_\_\_\_\_

Date

OCT 18 1939 19

S. J. LEWIS Scout

Map No. 49 Sec. 10 Twp. 19 R. 9W

Well No. 1 Cramm "B"

McPherson Drilling Company

Contractor

COMPLETED

SW/C

SECTION PLAT

\_\_\_\_\_ Ft. from N. Line

330 Ft. from S. Line

\_\_\_\_\_ Ft. from E. Line

330 Ft. from W. Line


CRAMM POOL

Location \_\_\_\_\_

Rig up \_\_\_\_\_

Drilling and Remarks:

*Cor 83197*  
*7" @ 3197*  
*3000 acc'l*  
*Depthograph Prod.*  
*756*

RECORD

Cased \_\_\_\_\_ in., \_\_\_\_\_ ft.

Sand \_\_\_\_\_

Gas \_\_\_\_\_

Oil \_\_\_\_\_

Total Depth 3211

PRODUCTION

1st 24 hrs. Nat. \_\_\_\_\_

1st 24 hrs. after shot \_\_\_\_\_

Gas \_\_\_\_\_ Cu. Ft.

Dry Hole \_\_\_\_\_

Abandoned \_\_\_\_\_

Date

DEC 20 1939 19

S. J. LEWIS Scout