

KANSAS


Rice

Form 51—5M—7-39—Palace

Section 10 Township 19 Range 9-W

Well No. #1 Cramm "C"

Company McPherson Drilling

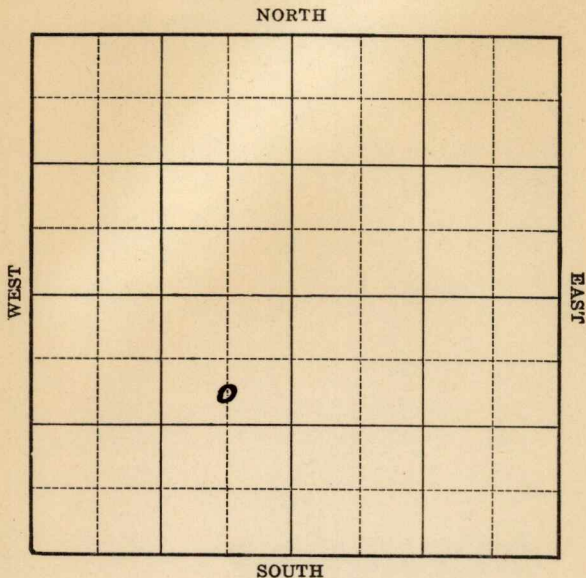

KANSAS

Rice

Sec. 10 Twp. 19 R. 9-WWell No. #1 Cramm "C" FarmMcPherson Drilling Company


(Cramm)

990 Ft. from N. Line

Ft. from S. Line

660 Ft. from E. Line

Ft. from W. Line

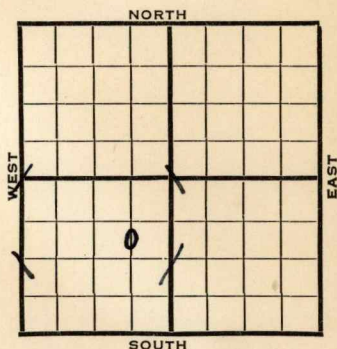

1940

REPORT

6/5 10" - 109'

Anhy. 360'

Drlg. 2740'

6/12 Arb. 3345'

T.D. 3363'

No shows.

ABANDONED

Map No. 49 Sec. 10 Twp. 19 R. 9WWell No. 1 Cramm "C"

McPherson Drilling

Company

Contractor

FIRST REPORT

SECTION PLAT

C S L NE SW


990 Ft. from N. Line

Ft. from S. Line

660 Ft. from E. Line

Ft. from W. Line

CRAMM POOL

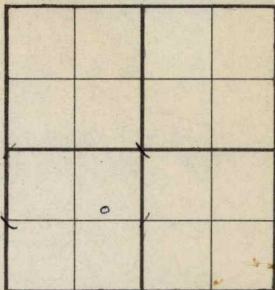

Location _____

Rig up _____

Drilling and Remarks:

10" - 109

Anhy. 360

Drlg. 2740

RECORD

Cased _____ in., _____ ft.

Sand _____

Gas _____

Oil _____

Total Depth _____

PRODUCTION

1st 24 hrs. Nat. _____

1st 24 hrs. after shot _____

Gas _____ Cu. Ft.

Dry Hole _____

Abandoned _____

Date

JUN 5 1940 19

S. J. LEWIS

Scout

Map No. 49 Sec. 10 Twp. 19 R. 9WWell No. 1 Cramm "C"McPherson Drilling Company

Contractor

ABANDONED

C S L NE SW

990 Ft. from N. Line Ft. from S. Line660 Ft. from E. Line Ft. from W. Line

SECTION PLAT

GRAMM POOL

Location Rig up

Drilling and Remarks:

*Cor & 3345**No shows*

RECORD

Cased in., ft.Sand Gas Oil Total Depth 3363

PRODUCTION

1st 24 hrs. Nat. 1st 24 hrs. after shot Gas Cu. Ft.Dry Hole Abandoned

Date

JUN 12 1940 19S. J. LEWIS Scout