

DX 78-1

KANSAS

Company Bergman

NORTH

WEST

EAST

SOUTH

Rice

KANSAS

SEC.	TWP.	R.
10	19	9W

WELL NO.

#2 Piehler

FARM

COMPANY

Bergman

CONTRACTOR

Schafer

Chase-Silica Pool

NORTH

Ft. from N. Line


990

Ft. from S. Line

330

Ft. from E. Line

Ft. from W. Line

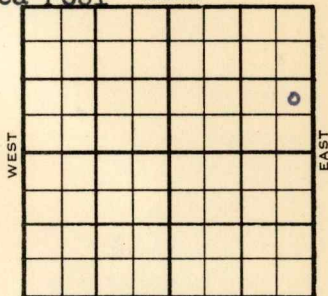

NE SE NE

SOUTH

	ELEVATION	REPORT
1954	1727'	

9/8

Spud 9-5-54
8" @ 144'
Drlg. 1285'

11/10

Spud 9-5-54 - Oil Well

TD 3345'

8" @ 144'

Heeb 2748', Br lime 2876', Lans 2903'

DST 2926-36', opn 1 hr., rec. 30' mud,
85#Sh. Cong. 3226', Sd Cong 3285', Simp
sd 3294', Arb. 3332'

TD 3345'

5" @ 3345'

16/3294-98

Comp. 20 bopd

COMPLETED

Operator **Bergman**

Well No. **2** Farm **Piehler**

Elev.	Location	
		NE SE NE

0

FIRST REPORT

990 Ft. From S Line NE

330 Ft. From E Line Quarter

1st. Report SEP 8 1954

Completion

Remarks

Schafer - Contr.

Spudding Date 9-5-54

Drlg. Data Chase-Silica Pool

8" @ 144 drlg. 1285

FABEN GILSTRAP

