


Section 10 Township 19 Range 9W

Well No. #1 Saint

Company Shell et al

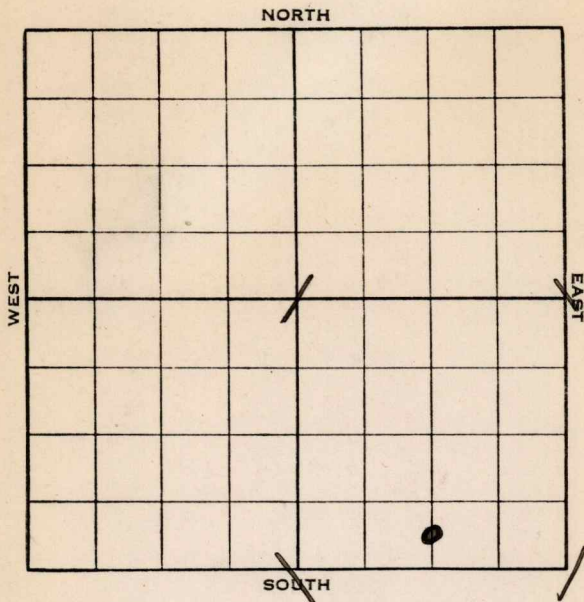

Rice

KANSAS

Map No. 49 Sec. 10 Twp. 19 R. 9WWell No. 1 SaintShell etal


Company

Contractor

FIRST REPORT

C S L SE

SECTION PLAT

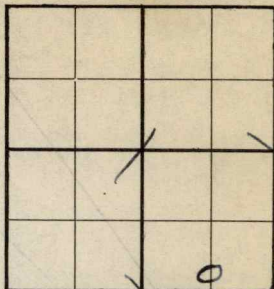 Ft. from N. Line330 Ft. from S. Line1320 Ft. from E. Line Ft. from W. LineLocation Rig up

Drilling and Remarks:

RUR

RECORD

Cased in., ft.Sand Gas Oil Total Depth

PRODUCTION

1st 24 hrs. Nat. 1st 24 hrs. after shot Gas Cu. Ft.Dry Hole Abandoned

Date

AUG 3 - 1938 19

H. D. Hatfield

Scout

Rice

KANSAS

Map No. 49 Sec. 10 Twp. 19 R. 9WWell No. 1 SaintShell etal

Company

Contractor

COMPLETED

C S L SE

 Ft. from N. Line330 Ft. from S. Line1320 Ft. from E. Line Ft. from W. Line

SECTION PLAT

			0

Location Rig up

Drilling and Remarks:

P-194/4 X 165/4

POT 992
S.W.

RECORD

Cased 4 in., 3260 ft.Sand Arb 3258Gas Oil Total Depth 3265

PRODUCTION

1st 24 hrs. Nat. 1st 24 hrs. after shot Gas Cu. Ft. Dry Hole Abandoned

Date

AUG 31 1938

19

H. D. Hatfield Scout