

KANSAS

Rice

Section 10 Township 19 Range 9W

Well No. 2 Saint

Company Lindas Oil

Chase Pool
NORTH

NORTH

WEST

EAST

SOUTH

KANSAS

Rice

Sec. 10 Twp. 19 R. 9W

Well No. #2 Saint Farm

Lindas Oil

Company

Chase Pool

Ft. from N. Line

660'


Ft. from S. Line

330'

Ft. from E. Line

Ft. from W. Line

C E L S E S E

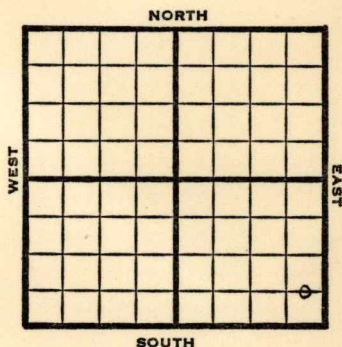

1949

Elev 1725'

REPORT

1/5

8" @ 167'
Drlg. 1610'

1/12

Drlg 3020

1/19

Simpson 3209'-75'

TD 3275'

5"@ 3209'

1/26

"

2/2

Shots 10 qts pipe collapsed

2/9

"

2/16

"

2/23

"

3/2

"

3/8

"

3/16

TD 3375'

Simp 3209'

5"@ 3209'

10 qts

Pump 40 oil Pot

44° Gr.

Comp

COMPLETED

Map No. _____ Sec. 10 Twp. 19 R. 9WWell No. 2 SaintLindas Oil CompanyFIRST REPORT Contractor


C E L S E S E

SECTION PLAT

_____ Ft. from N. Line

660 Ft. from S. Line330 Ft. from E. Line

_____ Ft. from W. Line

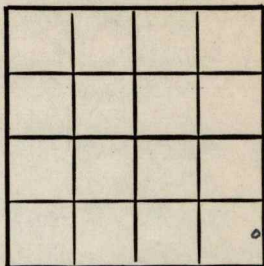

Rice County

Location _____

Rig up _____

Drilling and Remarks:

8" @ 167

drlg. 1610

RECORD

Cased _____ in., _____ ft.

Sand _____

Gas _____

Oil _____

Total Depth _____

PRODUCTION

1st 24 hrs. Nat. _____

1st 24 hrs. after shot _____

Gas _____ Cu. Ft.

Dry Hole _____

Abandoned _____

Date

JAN 5 1949

19

S. J. LEWIS

Scout


Kansas

Map No. K49 Sec. 10 Twp. 19 R. 9WWell No. 2 SaintLindas Oil

Company

COMPLETE

Contractor

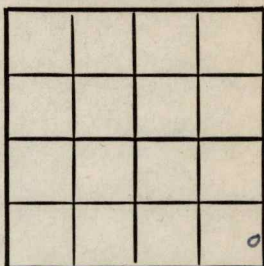C E L S E S EE 1.1725
SECTION PLAT Ft. from N. Line660 Ft. from S. Line330 Ft. from E. Line Ft. from W. LineRice CountyLocation Rig up

Drilling and Remarks:

String 320932" @ 3209109 ft.Pump 40 oil442 ft

RECORD

Cased in., ft.Sand Gas Oil Total Depth 3225'

PRODUCTION

1st 24 hrs. Nat. 1st 24 hrs. after shot Gas Cu. Ft.Dry Hole Abandoned

Date

MAR 16 1949 19S. J. LEWIS Scout