


Section 11 Township 19 Range 9WWell No. #4 Soeken "A"Company Bergman Oil

NORTH

WEST

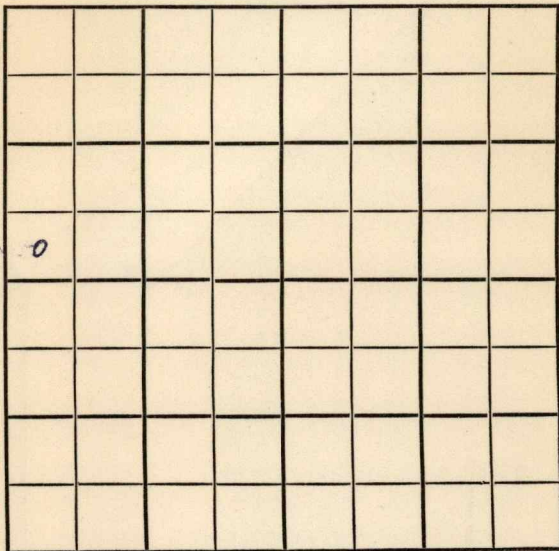

EAST

SOUTH

Rice

KANSAS

SEC.	TWP.	R.
11	19	9 W

WELL NO.

4 Soeken "A"

FARM

COMPANY

Bergman Oil

CONTRACTOR

Schafer

Chase-Silica Pool


Ft. from N. Line

330 Ft. from S. Line

Ft. from E. Line

330 Ft. from W. Line

SW SW NW

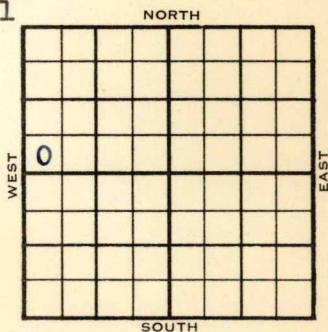

1954

ELEVATION

1731'

REPORT

12/22

Spud 12-15-54

8" @ 145

Drlg. 2711'

County **Rice** State **Kansas**
 Sec. **11** (Blk. Twp.) **19** (Sur. Rge.) **9W** Map No.
 Operator **Bergman Oil**
 Well No. **4** Farm **Soeken "A"**
 Elev. **1731** Location **SW SWNW**

0						

330 Ft. From **S** Line **NW**

330 Ft. From **W** Line Quarter

Ist. Report **DEC 22 1954**

Completion

Remarks

Schafer - Contr.

Spudding Date **12-15-54**

Drlg. Data

Chase-Silica Pool

8" @ 145 drlg. 2711

FABEN GILSTRAP