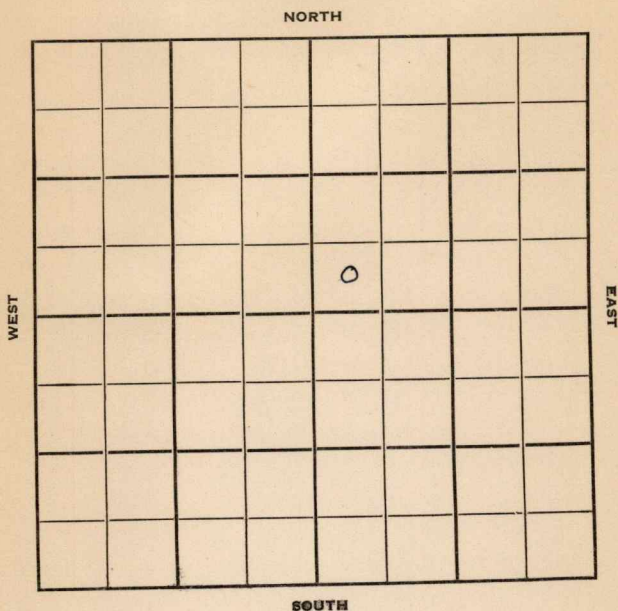


Section 14 Township 19 Range 9-WWell No. #1 GibsonCompany K & E Drlg.

Rice
19

KANSAS

9W

Sec. 14 Twp. _____ R. _____

Well No. #1 Gibson Farm _____

K & E Drlg.

Company _____

Contractor _____

Chase Pool

Ft. from N. Line

330'


Ft. from S. Line

Ft. from E. Line

330'

Ft. from W. Line

SW SW NE

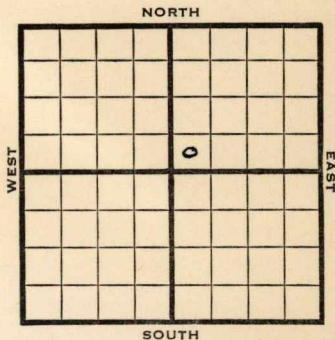

1950

Elev 1748

REPORT

7/5 Cellar & Pits

7/19 8 5/8" @ 170

Br lime 2895

Viola 3252

TD 3341

D&A

Lans 2921

Simp 3291-3341

ABANDONED

Map No. _____ Sec. 14 Twp. 19 R. 9W

Well No. 1 Gibson


K & E Drlg.

Company

Contractor

SW SW NE

SECTION PLAT

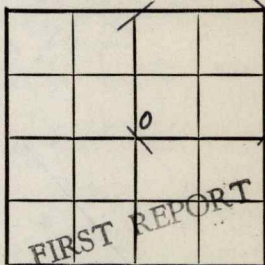

_____ Ft. from N. Line

330 Ft. from S. Line

_____ Ft. from E. Line

330 Ft. from W. Line

Rice County

Location _____

Rig up _____

Drilling and Remarks:

Cellar & Pits

RECORD

Cased _____ in., _____ ft.

Sand _____

Gas _____

Oil _____

Total Depth _____

PRODUCTION

1st 24 hrs. Nat. _____

1st 24 hrs. after shot _____

Gas _____ Cu. Ft.

Dry Hole _____

Abandoned _____

Date

JUL 5 1950 19

J. E. TYRA Scout

Kansas

Map No. _____ Sec. 14 Twp. 19 R. 9WWell No. 1 GibsonK & E Drfg. Company

Contractor


SW SW NE

El. 1748
SECTION PLAT

_____ Ft. from N. Line

330 Ft. from S. Line

_____ Ft. from E. Line

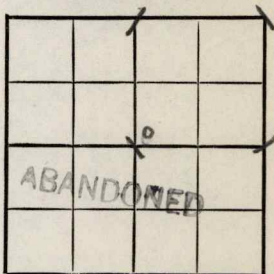330 Ft. from W. Line

Rice County

Location _____

Rig up _____

Drilling and Remarks:

8 5/8" @ 170

Br. lime 2895

Lans. 2921

Viola 3252

Simp. 3291-3341

D & A

RECORD

Cased _____ in., _____ ft.

Sand _____

Gas _____

Oil _____

Total Depth 3341

PRODUCTION

1st 24 hrs. Nat. _____

1st 24 hrs. after shot _____

Gas _____ Cu. Ft.

Dry Hole _____

Abandoned _____

Date

JUL 19 1950

19

J. E. TYRA

Scout