


Section 14 Township 19 Range 9W

Well No. #5 Maes

Company Sharon Drlg.

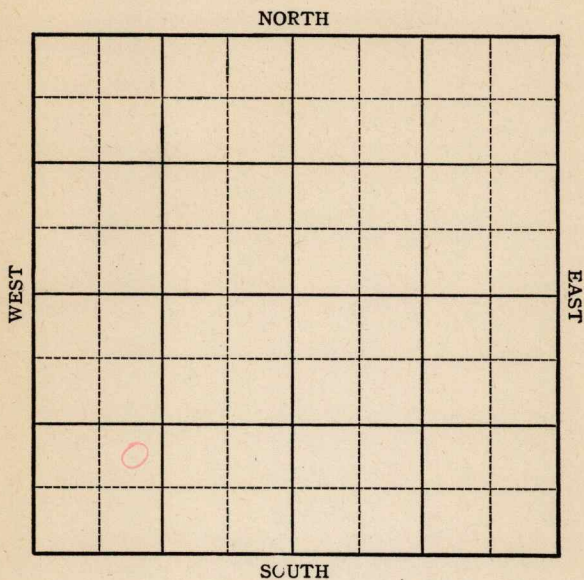

KANSAS

Rice County

Sec. 14 Twp. 19 R. 9W

Well No. #5 Maes Farm _____

Sharon Drlg. Company _____


Chase

_____ Ft. from N. Line

990 Ft. from S. Line

_____ Ft. from E. Line

990 Ft. from W. Line

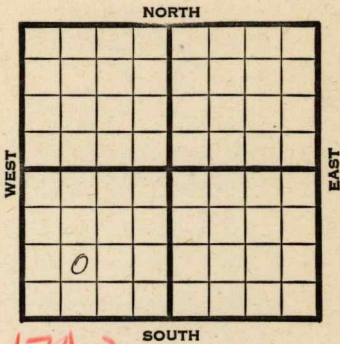

NE SW SW *Elev. 1742*

1945 REPORT

3/28 10" @ 190' WOC
 4/5 **Angy** 360
Topeka 2463
 Drilling 2747'

4/12 **Lans** 2901
Arb 3252
 5" @ 3253
 TD 3263

4-18 **Arbuckle 3252'**
 5" at 3253'
 500 acid
 Pump 110 pot. 41.3 Gravity
 Total Depth 3266'

COMPLETED

Kansas Pool Name Chase

Map No. 49 Sec. 14 Twp. 19 R. 9W

Well No. 5 Maes

Sharon Drl g. Company

COMPLETED Contractor

NE SW SW

E 11742
SECTION PLAT

_____ Ft. from N. Line

990 Ft. from S. Line

_____ Ft. from E. Line

990 Ft. from W. Line

Rice

Location _____

Rig up _____

Drilling and Remarks:

Ar 8 3252
5' @ 3253
500 acid
Pump 110 P & X

4 1/2 gal

RECORD

Cased _____ in., _____ ft.

Sand _____

Gas _____

Oil _____

Total Depth 3266

PRODUCTION

1st 24 hrs. Nat. _____

1st 24 hrs. after shot _____

Gas _____ Cu. Ft.

Dry Hole _____

Abandoned _____

Date

APR 1 8 1945 19

S. J. LEWIS Scout