


KANSAS

RICE

Section 14 Township 19 S Range 9 W

Well No. #6 Maes

Company SHARON DRLG.

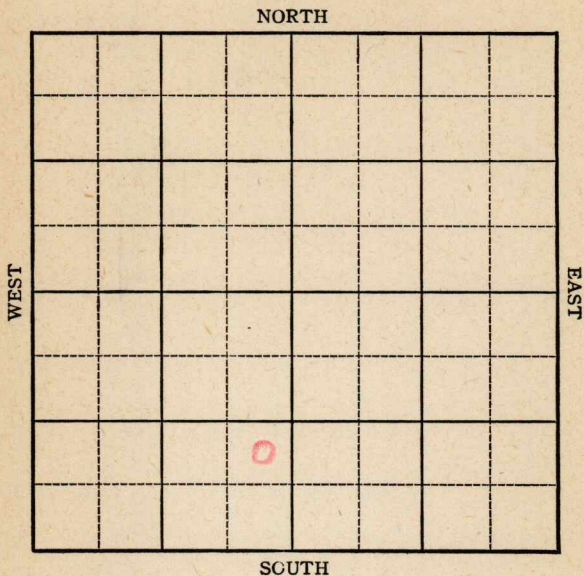

KANSAS

Rice County

Sec. 14 Twp. 19 R. 9W

Well No. #6 Maes Farm

Sharon Drlg.

Company


Chase

 Ft. from N. Line

990 Ft. from S. Line

330 Ft. from E. Line

 Ft. from W. Line

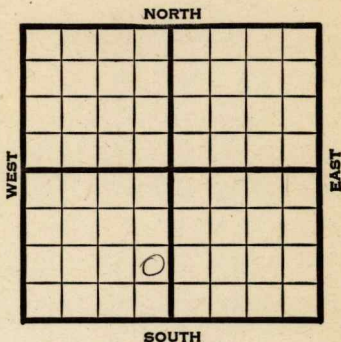

NE SE SW

1945

Elev. 1750

R E P O R T

4/11 10" @ 198' WOC

4/20 Drlg. 2735

4/27 **Lans** 2915

Arb 3243

5" @ 3243

TD 3248

3100' oil in 6 hrs.

" " " " "

5/3

5/16

Arb 3243

5" @ 3243

TD 3248

Pump 384 Pot.

Grav. 42.0

COMPLETED

Kansas Pool Name Chase

Map No. 49 Sec. 14 Twp. 19 R. 9W

Well No. 6 Maes


Sharon Drlg. Company

FIRST REPORT

Contractor

NE SE SW

SECTION PLAT

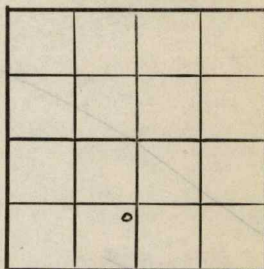

 Ft. from N. Line

990 Ft. from S. Line

330 Ft. from E. Line

 Ft. from W. Line

Rice

Location

Rig up

Drilling and Remarks:

10"-198 WOC

RECORD

Cased in., ft.

Sand

Gas

Oil

Total Depth

PRODUCTION

1st 24 hrs. Nat.

1st 24 hrs. after shot

Gas Cu. Ft.

Dry Hole

Abandoned

Date

APR 1 1 1945

19


S. J. LEWIS Scout

Pool Name Chase

Kansas

Map No. 49 Sec. 14 Twp. 19 R. 9WWell No. 6 MaesSharon Drlg. CompanyCOMPLETED Contractor

NE SE SW

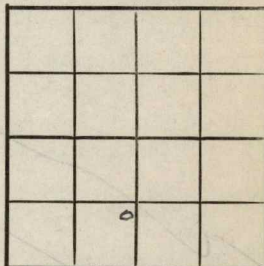E 1/2 50
SECTION PLAT Ft. from N. Line990 Ft. from S. Line330 Ft. from E. Line Ft. from W. Line

Rice County

Location Rig up

Drilling and Remarks:

Or 32435" @ 3243Pump 384 P.D.42 @ 42

RECORD

Cased in., ft.Sand Gas Oil Total Depth 3248

PRODUCTION

1st 24 hrs. Nat. 1st 24 hrs. after shot Gas Cu. Ft.Dry Hole Abandoned

Date

MAY 16 1945 19 S. J. LEWIS Scout