

KANSAS


FORM 51 5M 6-46 PETROL

Rice county

Section 14 Township 19 Range 9-W

Well No. #8, Maes

Company Sohio

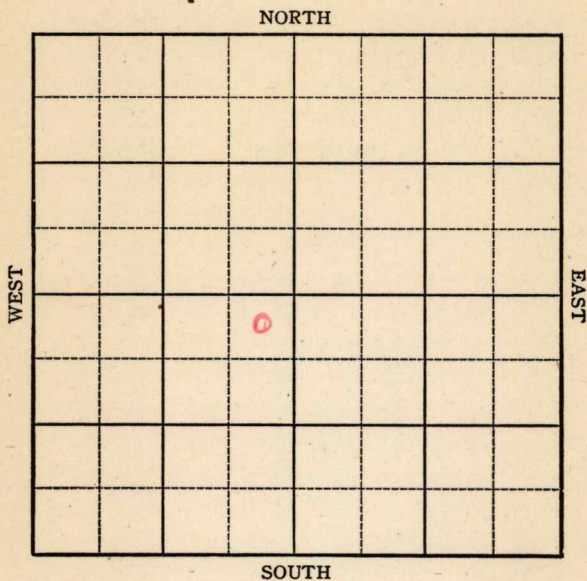

KANSAS

Rice

Sec. 14 Twp. 19 R. 9W

Well No. 8 Maes Farm

Sohio

Company

Chase


330 Ft. from N. Line

 Ft. from S. Line

330 Ft. from E. Line

 Ft. from W. Line

NORTH

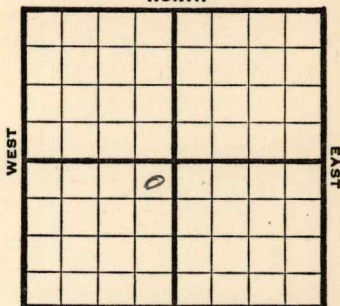

SOUTH

NE SW

REPORT

1946	Elev. 1749'
11/20	8" @ 224'
	WOC
11/27	Drlg 3050'
12/3	Arb 3269'-72 TD
	5" @ 3270', RUST
12/10	TD 3274,
	Swb 3 oil PH 5 hrs
12/17	" "
1947	
1/2	Arb 3269'
	5" @ 3270'
	TD 3274'
	Pump 75 POT
	42 Grav.

COMPLETED

Kansas

KANSAS

Chase Pool

Map No. 49 Sec. 14 Twp. 19 R. 9WWell No. 8 Maes

Sohio

Company

FIRST REPORT

Contractor

NE SW

SECTION PLAT

330 Ft. from N. Line Ft. from S. Line330 Ft. from E. Line Ft. from W. Line

	0		

Rice County

Location Rig up

Drilling and Remarks:

8" @ 224 WOC

RECORD

Cased in., ft.Sand Gas Oil Total Depth

PRODUCTION

1st 24 hrs. Nat. 1st 24 hrs. after shot Gas Cu. Ft.Dry Hole Abandoned

Date

NOV 20 1946

19

S. J. LEWIS

Scout

Kansas

KANSAS

Map No. 49 Sec. 14 Twp. 19 R. 9WWell No. 8 Maes

Sohio

Company

COMPLETED

Contractor

NE SW

E1, 1749.

SECTION PLAT

330 Ft. from N. Line Ft. from S. Line330 Ft. from E. Line Ft. from W. Line

	0		

Rice County

Location Rig up

Drilling and Remarks:


RECORD

Cased in., ft.Sand Gas Oil Total Depth 8274

PRODUCTION

1st 24 hrs. Nat. 1st 24 hrs. after shot Gas Cu. Ft.Dry Hole Abandoned

Date

JAN 2 1947 19

S. J. LEWIS Scout