

Rice

Section 10 Township 19 Range 9 WWell No. # 1 Soeken "B"Company J. Bergman Oil

						0	

NORTH

WEST

EAST

SOUTH

Rice

KANSAS

SEC.	TWP.	R.
10	19	9 W

WELL NO.

1 Soeken "B"

FARM

COMPANY

J. Bergman Oil

CONTRACTOR

Shaffers

Chase-Silica Pool


990 Ft. from N. Line

Ft. from S. Line

990 Ft. from E. Line

Ft. from W. Line

SW NE NE

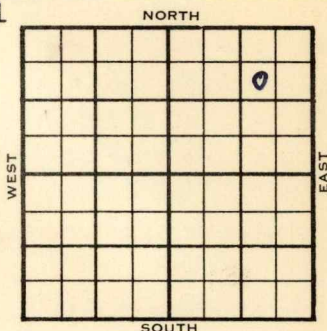

	ELEVATION	REPORT
1953	1718'	
10/28	Spud 10-23-53 8" @ 141 Drlg. 1806'	
11/4	RTD 3345' 5" @ 3345'	
11/11	NR	
11/18	Anhy 360', Heeb 2739', Br li 2868', Lans 2895' DST 2913-28', 1 hr., 1560' gas, 165' O&OCM, 45' wtr, 435# Cong 3224', Simp. 3306' DST 3297-3315', 1 hr., 225' wtr, 850# Arb. 3342' RTD 3345' 5" @ 3345' CO, SP 2950 24/2921-27'	
12/9	NR	
1954 1/13	NR	
1/27	Spud 10-23-53 D & A TD 3345' 8" @ 141'	

OVER

1954

Information brought forward.

1/27

Anhy 360', Heeb 2739', Br. Lime 2868'
Lans 2895'

DST 2913'-28' opn 1 hr, rec 1560' gas
165' o & ocm, 45' Wtr. 435#

Cong. 3224', Simp 3306',

DST 3297'-3315' opn 1 hr, rec 225' wt
850#

Abb 33428

TD 3345'

5" @ 3345'

SP 2950 24/ 2921-27 HFW

D & A

ABANDONED

Operator J. Bergman Oil

Well No. 1 Farm Soeken "B"

Elev.	1718	Location	SW NE NE
-------	------	----------	----------

0

ABANDONED

990 Ft. From N Line NE

990 Ft. From ^E Line Quarter

1st. Report

Completion JAN 27 1954

Remarks Chase-Silica Pool

Shaffers - Contr.

Spudding Date 10-23-53

Drlg. Data D & A TD 3345

8" @ 141 Anhy 360 Heeb. 2739

Br. lime 2868 Lans. 2895 DST 2913-28

open 1 hr. Rec. 1560' gas 165' o & ocm

45' wtr. 435# Cong. 3224 Simp. 3306

DST 3297-3315 opne 1 hr. Rec. 225' wtr.

850# Arb. 3342 TD 3345 5" @ 3345

SP 2950 24/ 2921-27 HFW

D & A

J. G. McGEHEE