

Rice


FORM 51

KANSAS

Section 10 Township 19 Range 9W

Well No. #2 Socken "B" (Socken)

Company J. Bergman Oil

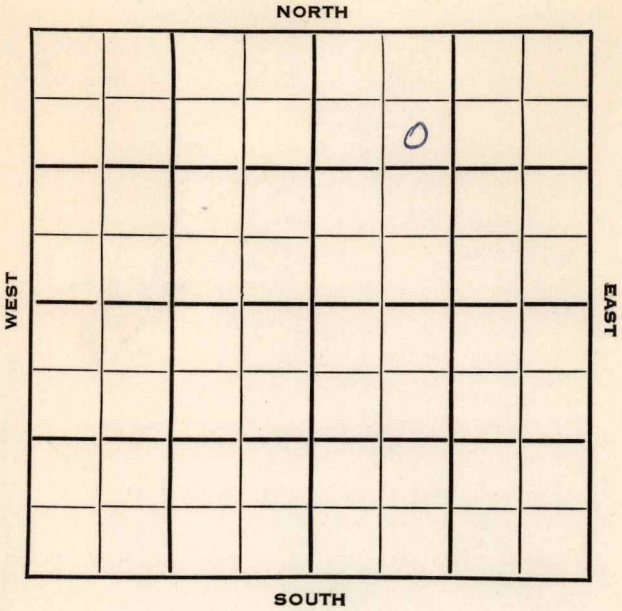

Rice

KANSAS

SEC.	TWP.	R.
10	19	9W

WELL NO.

#2 Socken "B"

FARM

COMPANY

J. Bergman Oil

CONTRACTOR

Schafer

Chase-Silica Pool NORTH

990


Ft. from N. Line

Ft. from S. Line

Ft. from E. Line

990

Ft. from W. Line

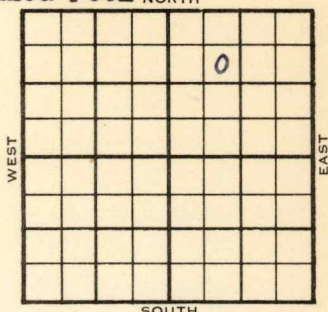

SE NW NE

	ELEVATION	REPORT
1953	1714'	

11/4 R U R

11/11 "

11/18 D&A

TD 3315'

Heeb 2737', Br lime 2866', Lans 2894'

DST 2911-30', opn 1 hr., rec. 360'

gas, 210' ocm, 360' sw, 950#

Cong. 3212', Simp. 3300'

TD 3315'

DST 3292-3315', opn 1 hr., rec. 145'

mud & wtr., 900#

D&A

ABANDONED

County Rice State KansasSec. 10 (Blk. Twp.) 19 (Sur. Rge.) 9W Map No.Operator J. Bergman OilWell No. 2 Farm Socken "B"Elev. Location SE NW NE

990 Ft. From N Line NE990 Ft. From W Line Quarter1st. Report NOV 4 1953

Completion

Remarks


Schafer - Contr.

Spudding Date

Drlg. Data Chase-Silica PoolR U R

J. G. McGEHEE

County Rice State Kansas
 Sec. 10 (Blk.) 19 (Sur.) 9W Map No.
 Operator J. Bergman Oil
 Well No. 2 Farm Socken "B"
 Elev. 1714 Location SE NW NE

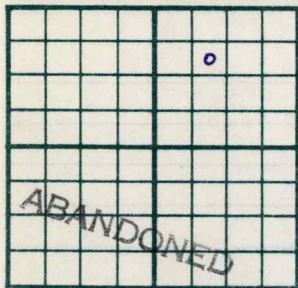

990 Ft. From N Line NE
990 Ft. From W Line Quarter

1st. Report

Completion NOV 18 1953

Remarks Chase-Silica Pool
Schafer - Contr.

Spudding Date

Drlg. Data D & A TD 3315
Heeb. 2737 Br. lime 2866 Lans. 2894
DST 2911-30 open 1 hr. Rec. 360' gas
210' ocm 360' sw 950# Cong. 3212
Simp. 3300 TD 3315 DST 3292-3315
open 1 hr. Rec. 145' mud & wtr. 900#
D & A

J. G. McGEHEE