


Section 11 Township 19 Range 9WWell No. #1 KratzerCompany Lindsley Drlg.

NORTH

WEST

EAST

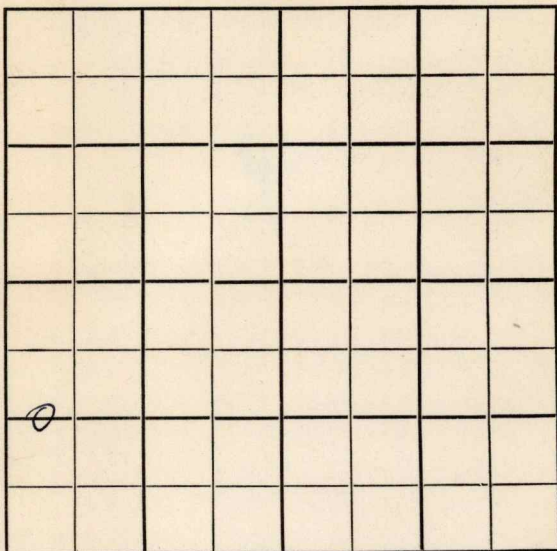

SOUTH

Rice

KANSAS

Sec. 11 Twp. 19 R. 9W ✓

Well No. #1 Kratzer Farm

Lindsley Drlg. Company

Contractor

Chase

Ft. from N. Line

1320


Ft. from S. Line

Ft. from E. Line

330

Ft. from W. Line

C W/2 W/2 SW

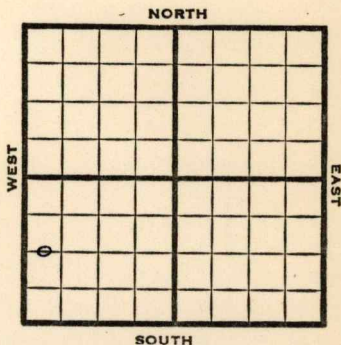

1951

Elev. 1728'

REPORT

10/31

Spud 10-23-51

8" @ 205'

Drlg. 2810'

11/14

Spud 10-23-51

D&A TD 3315

8" @ 205

Heeb. 2742 Br. Lime 2870

Lans. 2900

DST 3167-3287 open 1 hr.

Rec. 35' mud

B KC 32111 Cong. 3230

Simp. 3247 Arb. 3311-15 TD

D&A

ABANDONED

County	Rice		State	Kansas	
Sec.	11	(Blk. Twp.)	19	(Sur. Rge.)	9W
Map No.					

Sec. **11** (Blk.) **19** (Sur.) **9W** Map No.

Operator **Lindsley Drlg.**

Well No. **1** Farm **Kratzer**

Elev.	Location	C	W/2	W/2	SW
-------	----------	---	-----	-----	----

1320 Ft. From S Line SW

330 Ft. From W Line Quarter

1st. Report OCT 31 1951

Completion

Remarks

Spudding Date 10-23-51

Drlg. Data Chase

8" @ 205 Drlg. 2810

J. E. TYRA

County Rice State Kansas
 Sec. 11 (Blk.) 19 (Sur.) 9W Map No.

Operator Lindsley Drlg.

Well No. 1 Farm Kratzer

Elev. 1728 Location C W L W $\frac{1}{2}$ SW



1320 Ft. From S Line SW

330 Ft. From W Line Quarter

1st. Report

Completion NOV 14 1951

Remarks Chase Pool

Spudding Date 10-23-51

Drlg. Data D & A TD 3315

8" @ 205 Heeb. 2742 Br. lime 2870

Lans. 2900 DST 3167-3287 open 1 hr.

Rec. 35' mud B KC 3211 Cong. 3230

Simp. 3247 Arb. 3311-15 TD

D & A

J. E. TYRA