


Section 11 Township 19 Range 9W

Well No. #1 Kratzer

Company Bergman Oil

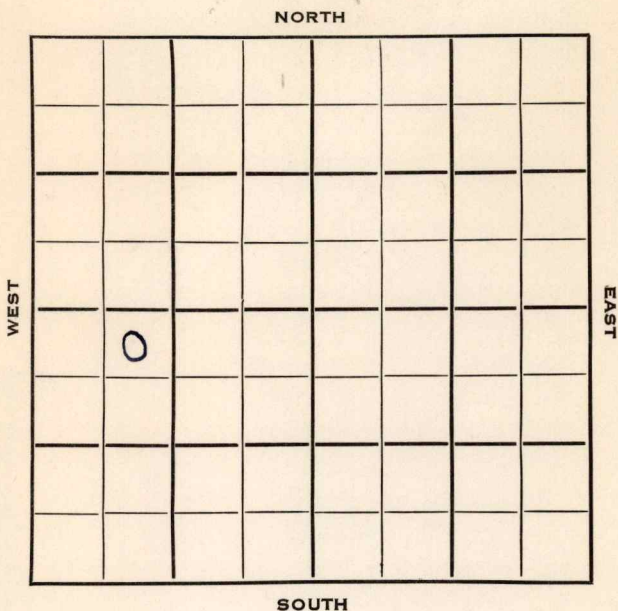

Rice

KANSAS

|      |      |    |
|------|------|----|
| SEC. | TWP. | R. |
| 11   | 19   | 9W |

WELL NO.

#1 Kratzer

FARM

COMPANY

Bergman Oil

CONTRACTOR

Schafer

Chase-Silica Pool

NORTH

330


Ft. from N. Line

Ft. from S. Line

Ft. from E. Line

990

Ft. from W. Line

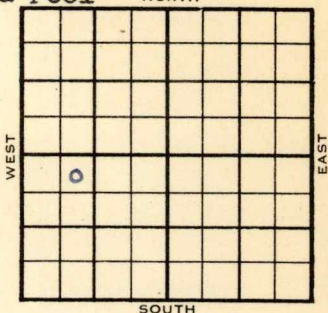

NE NWSW

ELEVATION

REPORT

1953

1732'

10/7

Spud 10-3-53

8" @ 154'

Anhy 375'

Drlg 1250'

10/14

Spud 10-3-53

D &amp; A TD 3381' 8" @ 154'

Anhy 375' Heeb 2758 Br lime 2889

Lans 2918

DST 3302-30 open 1 hr rec 80' mud

675# Arb. 3357

TD 3381 D &amp; A

ABANDONED



County Rice State KansasSec. 11 (Blk.  
Twp.) 19 (Sur.  
Rge.) 9W Map No.Operator Bergman OilWell No. 1 Farm KratzerElev. 1732 Location NE NW SW330 Ft. From N Line SW990 Ft. From W Line Quarter

1st. Report

Completion OCT 14 1953Remarks Chase-Silica PoolSchafer - Contr.Spudding Date 10-3-53Drlg. Data D & A TD 33818" @ 154 Anhy 375 Heeb. 2758Br. lime 2889 Lans. 2918 DST 3302-30open 1 hr. Rec. 80' mud 675#Arb. 3357 TD 3381D & A