


Rice

KANSAS

Section 11 Township 19 Range 9W

Well No. #1 Soeken

Company Bergman Oil

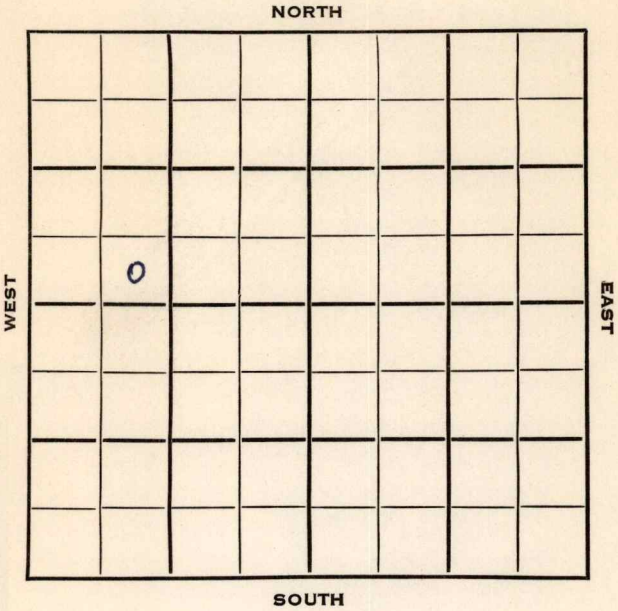

Rice

KANSAS

Sec. 11 Twp. 19 R. 9 WWell No. # 1 Soeken FarmBergman Oil Company

Contractor

Semi-Wildcat


Ft. from N. Line

330 Ft. from S. Line

Ft. from E. Line

990 Ft. from W. Line

SE SW NW

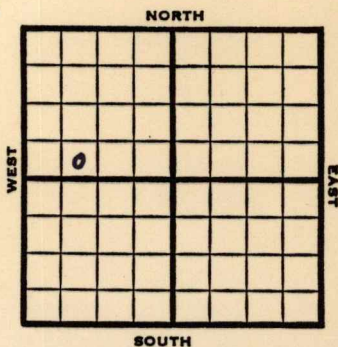

1953

Elev. 1733' REPORT

9/2

RUR

9/16

"

10/7

Oil well TD 3350 8" @ 145

H_eeb 2715 Br lime 2880 Lans 2909

Cong 3231 Simp 3304 Arb. 3348

TD 3350 5" @ 3350 50/3306-20

P/5 BOPH Comp. 50 BOPD

COMPLETED

J. G. McGEHEE

J. G. McGEHEE

100